



NORTH CENTRAL RAILWAY

JHANSI DIVISION

AS BUILT DIAGRAM OF 24 FIBER CABLE

SUB-SECTIONS :- **MALANPUR Stn. TO GOHAD ROAD Stn.**

DRAWN BY:-

BABA PROJECTS PVT. LTD.

2K/74, BARIATU HOUSING COLONY,

BARIATU, RANCHI-9, JHARKHAND


email :- bppl@bppl.org

As Built Diagram of 24F from MALANPUR Stn.TO GOHAD ROAD Stn.

SHEET NO. 1 of 5

SAC

GOA

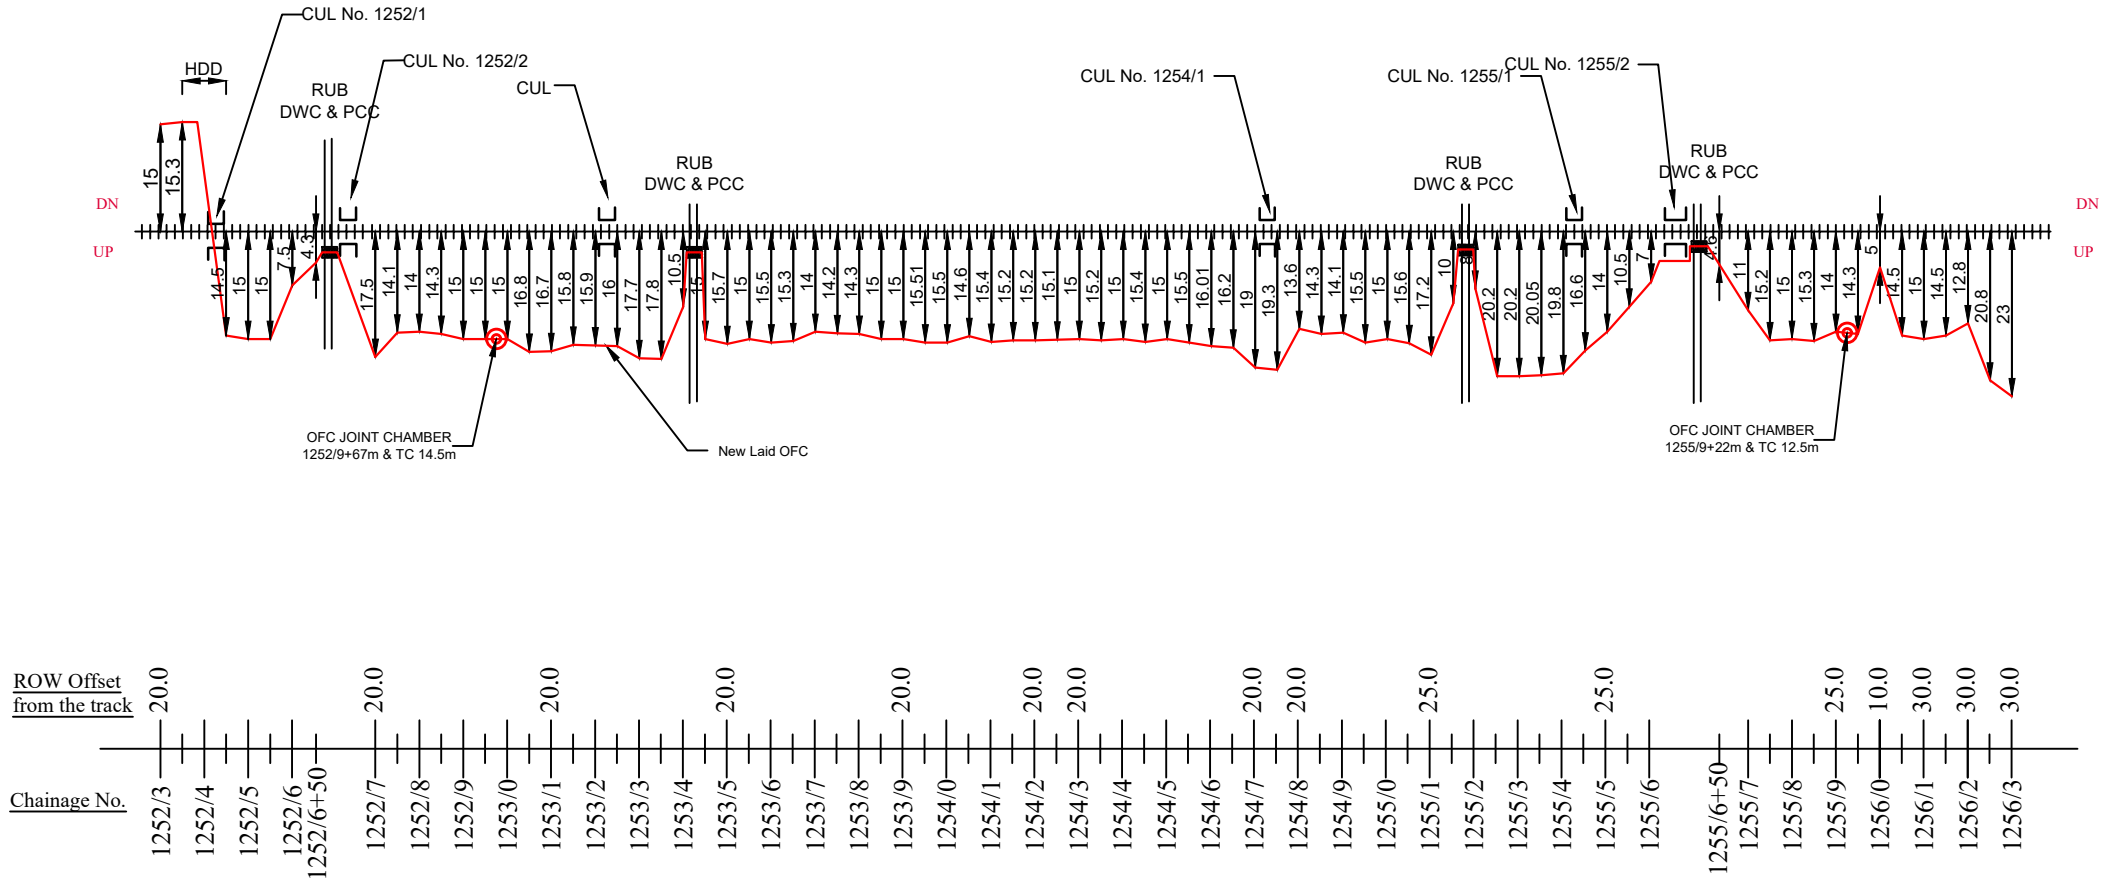

ROW Offset
from the track

Chainage No.

LEGENDS

RAILWAY LINE	=====
NEW LAID OFC	=====
OFC JOINT CHAMBER	⊙
LIMITED HEIGHT SUBWAY	
LC GATE/ LX GATE	⬅️ ➡️
CULVERT/BRIDGE	[]
DWC & PCC	[]
EXISTING 6 QUAD CABLE	=====

BABA PROJECTS
PVT. LTD.

DRAWN BY:-
Naval Kishor Singh

CHECKED BY:-

NORTH CENTRAL
RAILWAY

OFC ROUTE DIAGRAM
FOR THE ROUTE
GWALIOR TO ETAWAH

ALL DIMENSION ARE IN METER
(NOT TO SCALE)

Note: - Existing Quad cable is laid in DN Side (In opposite side of Proposed OFC).

APPROVED BY RAILWAYS


Dy. CSTE/NCRPU/ALJN

ASTE/NCRPU/ALJN

SSE/T/PU/CNB

As Built Diagram of 24F from MALANPUR Stn.TO GOHAD ROAD Stn.

SHEET NO. 2 of 5

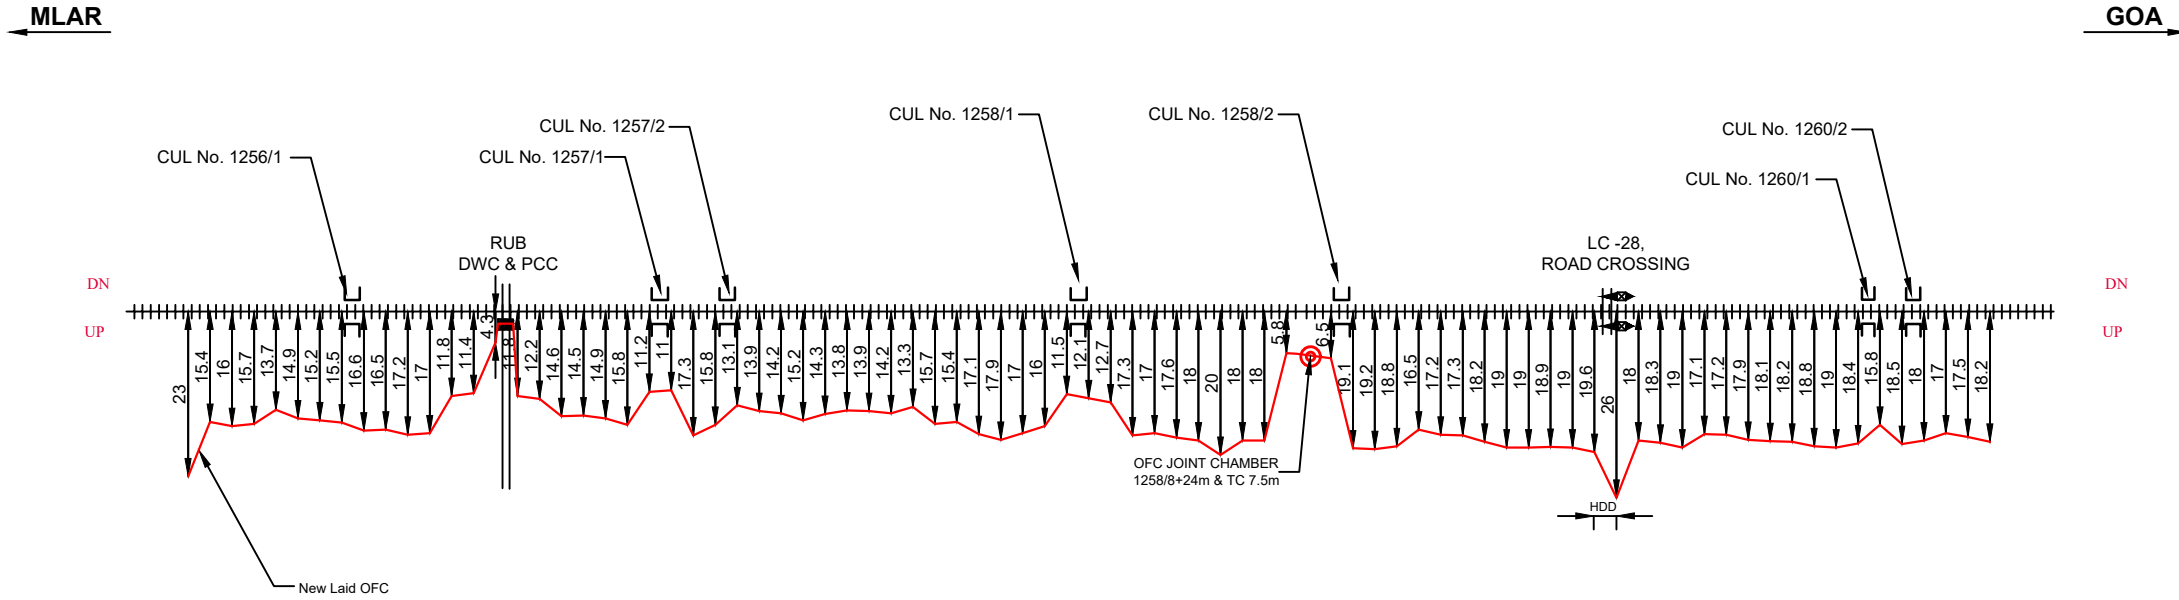

ROW Offset
from the track

Chainage No.

LEGENDS

RAILWAY LINE	+++++
NEW LAID OFC	—
OFC JOINT CHAMBER	⊙
LIMITED HIEGHT SUBWAY	
LC GATE/ LX GATE	⌈ ⌋
CULVERT/BRIDGE	⌈ ⌋
DWC & PCC	⌈ ⌋
EXISTING 6 QUAD CABLE	—

BABA PROJECTS PVT. LTD.	
DRAWN BY:- Naval Kishor Singh	CHECKED BY:-
ALL DIMENSION ARE IN METER (NOT TO SCALE)	

NORTH CENTRAL RAILWAY
OFC ROUTE DIAGRAM FOR THE ROUTE GWALIOR TO ETAWAH


APPROVED BY RAILWAYS		
Dy. CSTE/NCRPU/ALJN	ASTE/NCRPU/ALJN	SSE/T/PU/CNB

As Built Diagram of 24F from MALANPUR Stn.TO GOHAD ROAD Stn.

SHEET NO. 3 of 5

MLAR

GOA

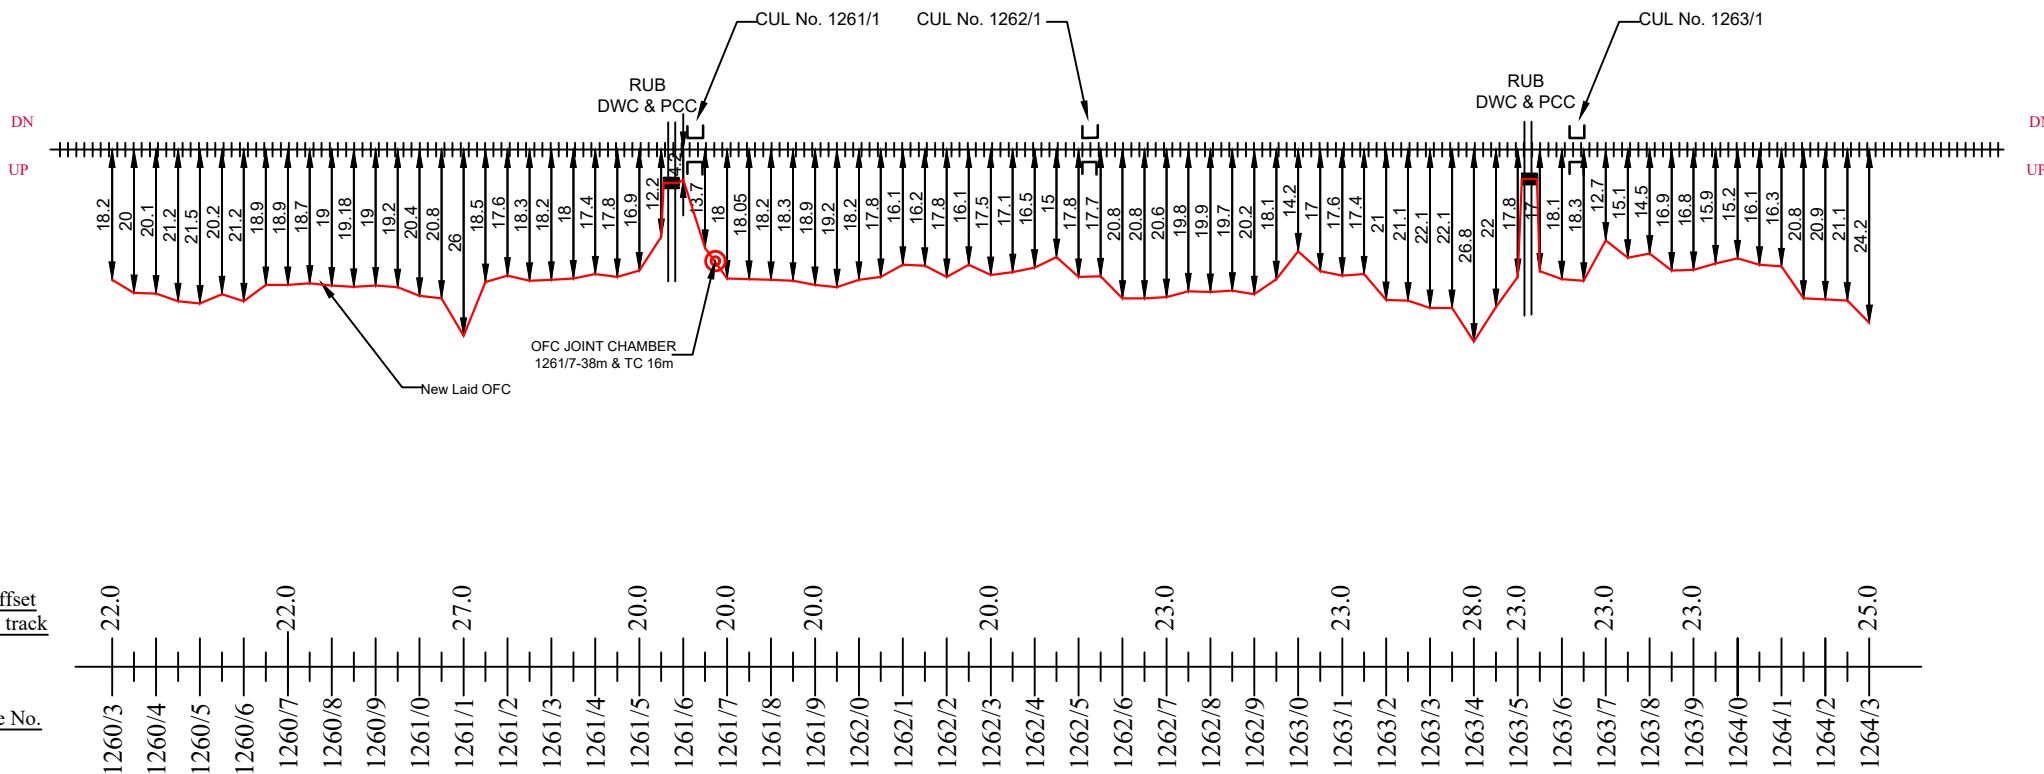

LEGENDS

RAILWAY LINE	+++++
NEW LAID OFC	—
OFC JOINT CHAMBER	⊙
LIMITED HEIGHT SUBWAY	
LC GATE/ LX GATE	⏏
CULVERT/BRIDGE	[]
DWC & PCC	[]
EXISTING 6 QUAD CABLE	—


BABA PROJECTS PVT. LTD.	
DRAWN BY:-	CHECKED BY:-
Naval Kishor Singh	
ALL DIMENSION ARE IN METER (NOT TO SCALE)	

NORTH CENTRAL RAILWAY
OFC ROUTE DIAGRAM FOR THE ROUTE GWALIOR TO ETAWAH

APPROVED BY RAILWAYS		
Dy. CSTE/NCRPU/ALJN	ASTE/NCRPU/ALJN	SSE/T/PU/CNB

SHEET NO. 4 of 5

GOA

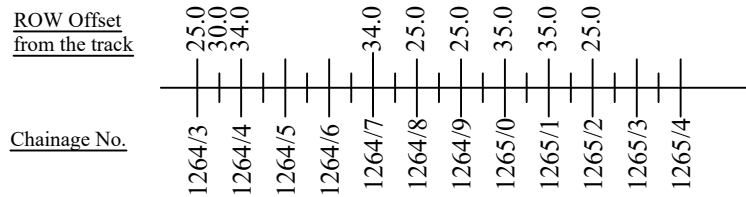

RAILWAY LINE	
NEW LAID OFC	
OFC JOINT CHAMBER	
LIMITED HEIGHT SUBWAY	
LC GATE/ LX GATE	
CULVERT/BRIDGE	
DWC & PCC	
EXISTING 6 QUAD CABLE	

BABA PROJECTS PVT. LTD.		NORTH CENTRAL RAILWAY	APPROVED BY RAILWAYS		
<u>DRAWN BY:-</u> Naval Kishor Singh	<u>CHECKED BY:-</u>	OFC ROUTE DIAGRAM FOR THE ROUTE GWALIOR TO ETAWAH			
ALL DIMENSION ARE IN METER (NOT TO SCALE)					


As Built Diagram of 24F from MALANPUR Stn.TO GOHAD ROAD Stn.

STATION - GOHAD ROAD (YARD AREA)

SHEET NO. 5 of 5

MLAR

SCN

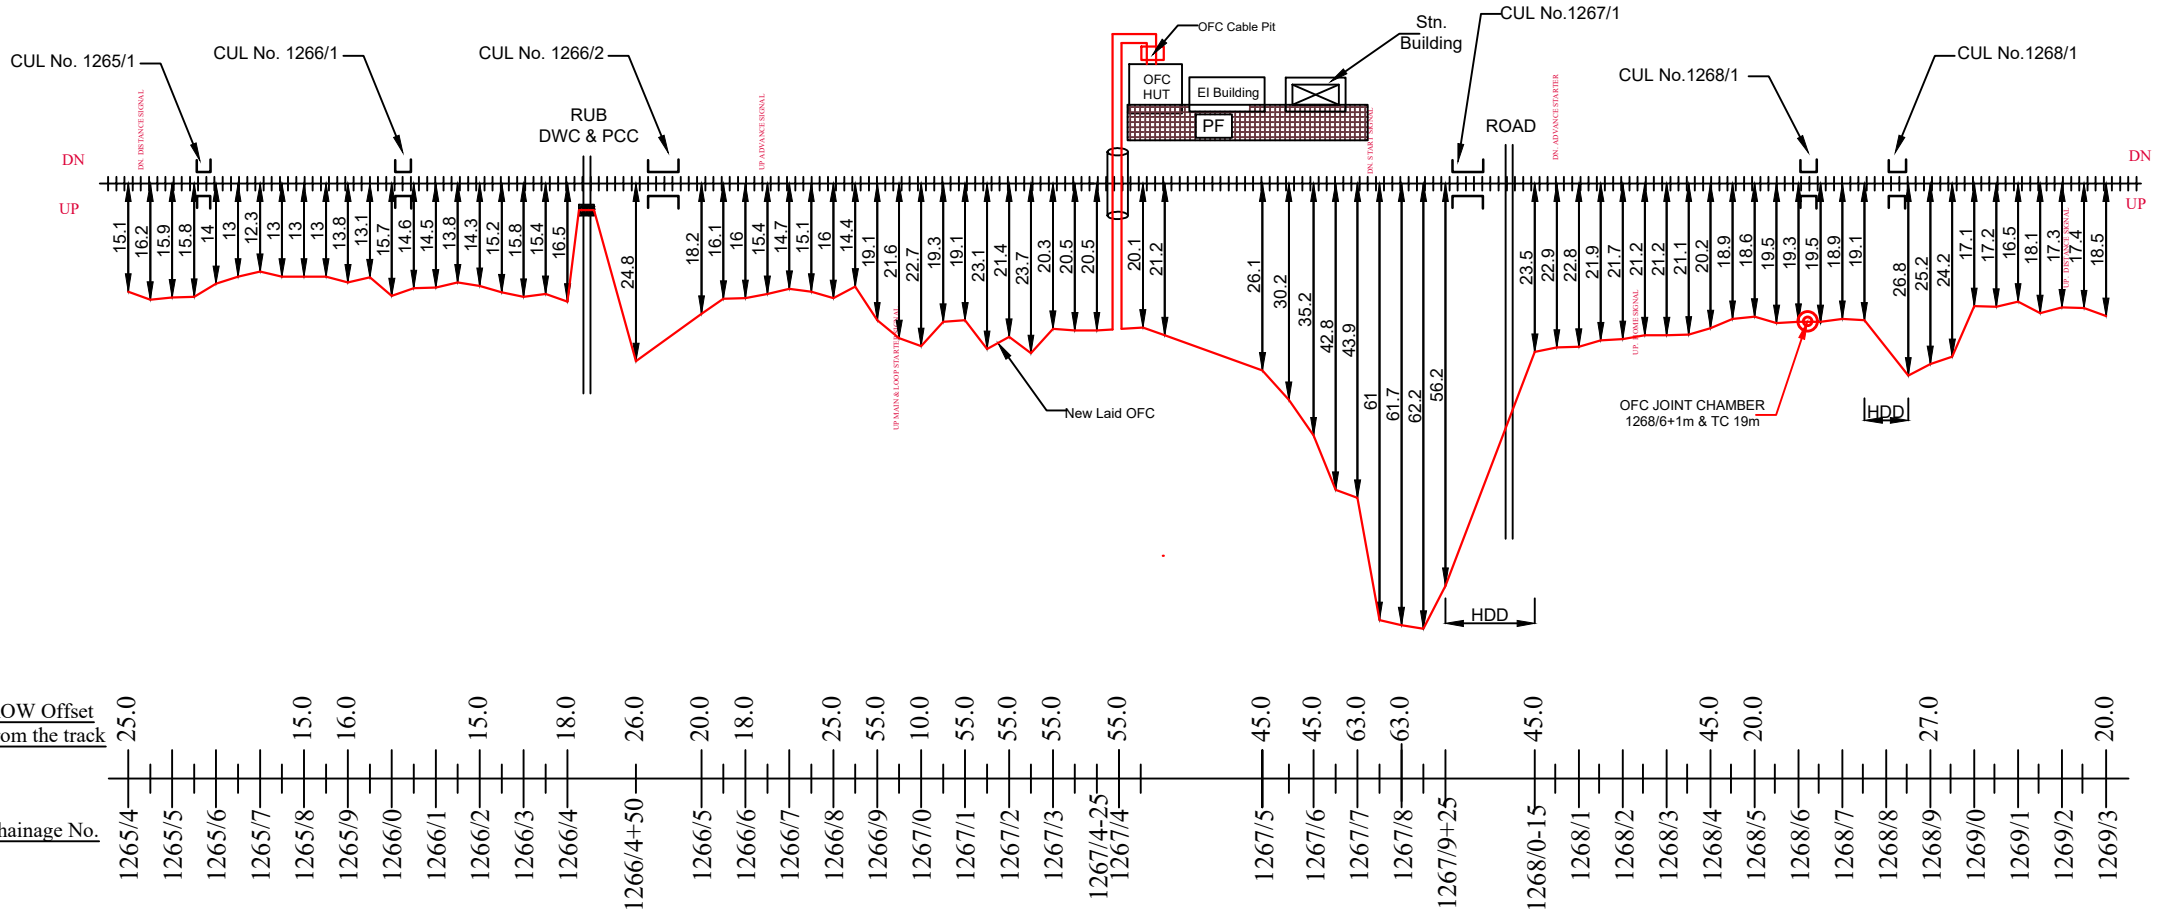

LEGENDS

STATION BUILDING	
OFC CABLE PIT	
RAILWAY LINE	
NEW LAID OFC	
OFC JOINT CHAMBER	
LIMITED HEIGHT SUBWAY	
LC GATE/ LX GATE	
CULVERT/BRIDGE	
DWC & PCC	
EXISTING 6 QUAD CABLE	

BABA PROJECTS PVT. LTD.	
DRAWN BY:-	CHECKED BY:-
Naval Kishor Singh	
ALL DIMENSION ARE IN METER (NOT TO SCALE)	

NORTH CENTRAL RAILWAY
OFC ROUTE DIAGRAM FOR THE ROUTE GWALIOR TO ETAWAH

APPROVED BY RAILWAYS		
Dy. CSTE/NCRPU/ALJN	ASTE/NCRPU/ALJN	SSE/T/PU/CNB

Note: - Existing Quad cable is laid in DN Side (In opposite side of Proposed OFC).