



NORTH CENTRAL RAILWAY

JHANSI DIVISION

AS BUILT DIAGRAM OF 24 FIBER CABLE

SUB-SECTIONS :- **BIRLANAGAR Stn. TO SHANICHARA Stn.**

DRAWN BY:-

BABA PROJECTS PVT. LTD.

2K/74, BARIATU HOUSING COLONY,

BARIATU, RANCHI-9, JHARKHAND

email :- bppl@bppl.org

SAC




OFC CABLE PIT		BABA PROJECTS PVT. LTD. <u>DRAWN BY:-</u> <i>Naval Kishor Singh</i> <u>CHECKED BY:-</u>	NORTH CENTRAL RAILWAY	APPROVED BY RAILWAYS			
RAILWAY LINE				OFC ROUTE DIAGRAM FOR THE ROUTE GWALIOR TO ETAWAH			
NEW LAID OFC							
OFC JOINT CHAMBER							
LIMITED HIEGHT SUBWAY							
LC GATE/ LX GATE							
CULVERT/BRIDGE		ALL DIMENSION ARE IN METER (NOT TO SCALE)					
DWC & PCC							
EXISTING 6 QUAD CABLE							
		<u>Dy. CSTE/NCRPU/ALJN</u>				<u>ASTE/NCRPU/ALJN</u>	<u>SSE/T/PU/CNB</u>

As Built diagram of 24F from BIRLANAGAR Stn. TO SANICHARA Stn.

SHEET NO. 2 of 6

BLNR

SAC

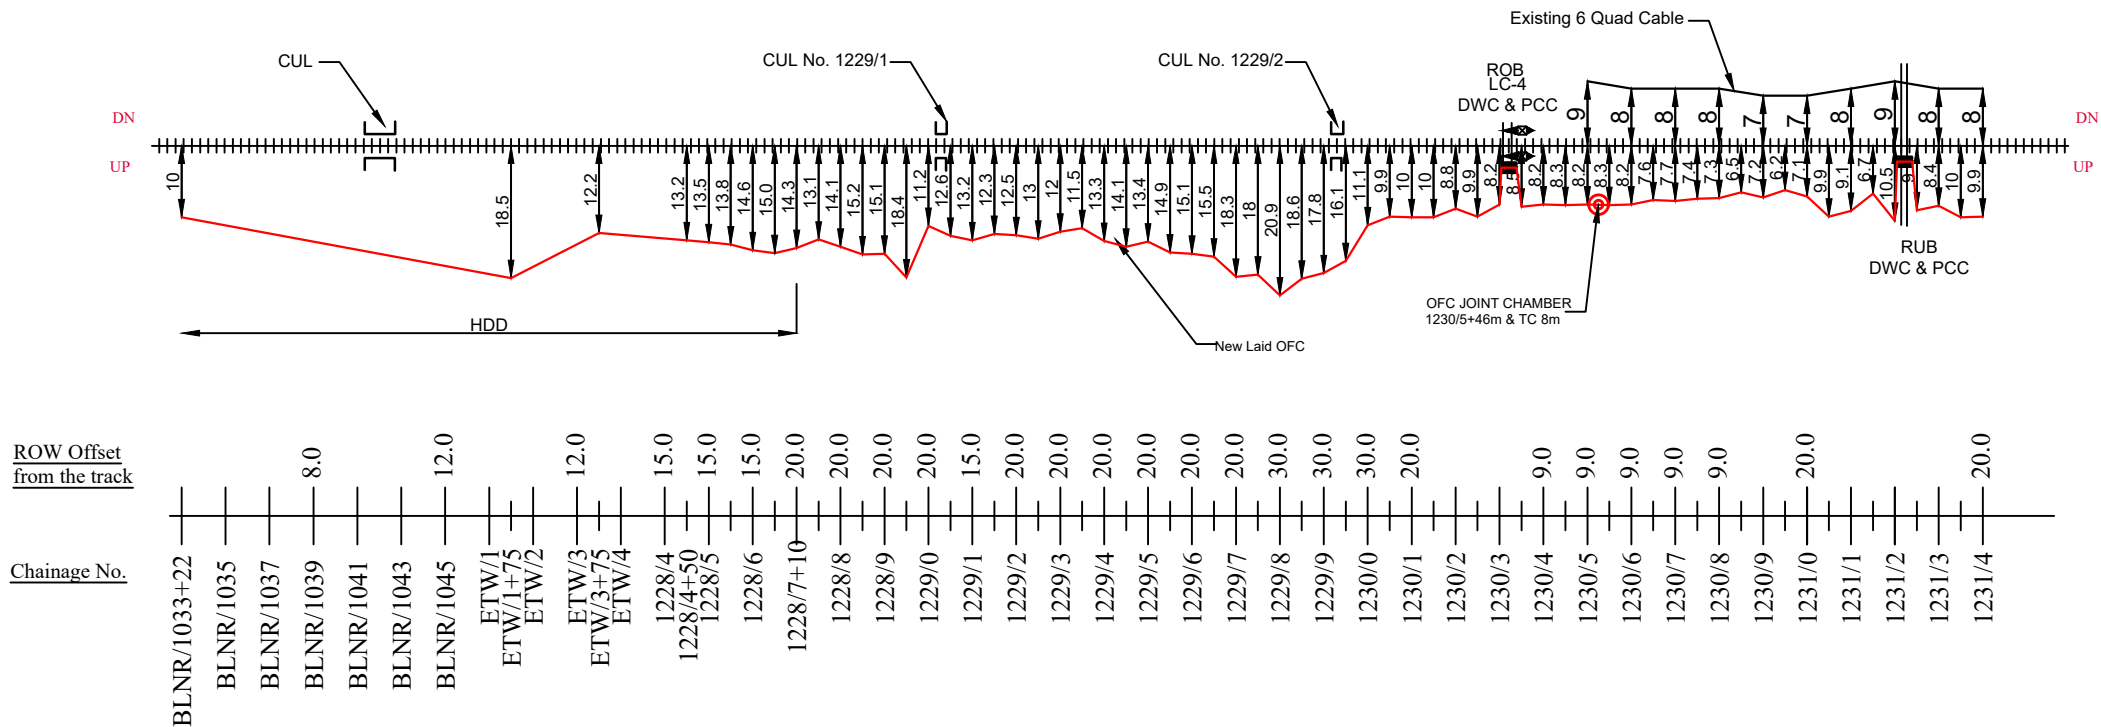

ROW Offset
from the track

Chainage No.

LEGENDS

RAILWAY LINE	=====
NEW LAID OFC	=====
OFC JOINT CHAMBER	⊙
LIMITED HIEGHT SUBWAY	==
LC GATE/ LX GATE	⌈ ⌋
CULVERT/BRIDGE	⌈ ⌋
DWC & PCC	⌈ ⌋
EXISTING 6 QUAD CABLE	=====


BABA PROJECTS PVT. LTD.	
DRAWN BY:- Naval Kishor Singh	CHECKED BY:-
ALL DIMENSION ARE IN METER (NOT TO SCALE)	

NORTH CENTRAL RAILWAY
OFC ROUTE DIAGRAM FOR THE ROUTE GWALIOR TO ETAWAH

APPROVED BY RAILWAYS		
Dy. CSTE/NCRPU/ALJN	ASTE/NCRPU/ALJN	SSE/T/PU/CNB

SHEET NO. 3 of 6

 SAC


SSE/T/PU/CNBSSE/T/PU/CNB

As Built diagram of 24F from BIRLANAGAR Stn. TO SANICHARA Stn.

SHEET NO. 4 of 6

BLNR

SAC

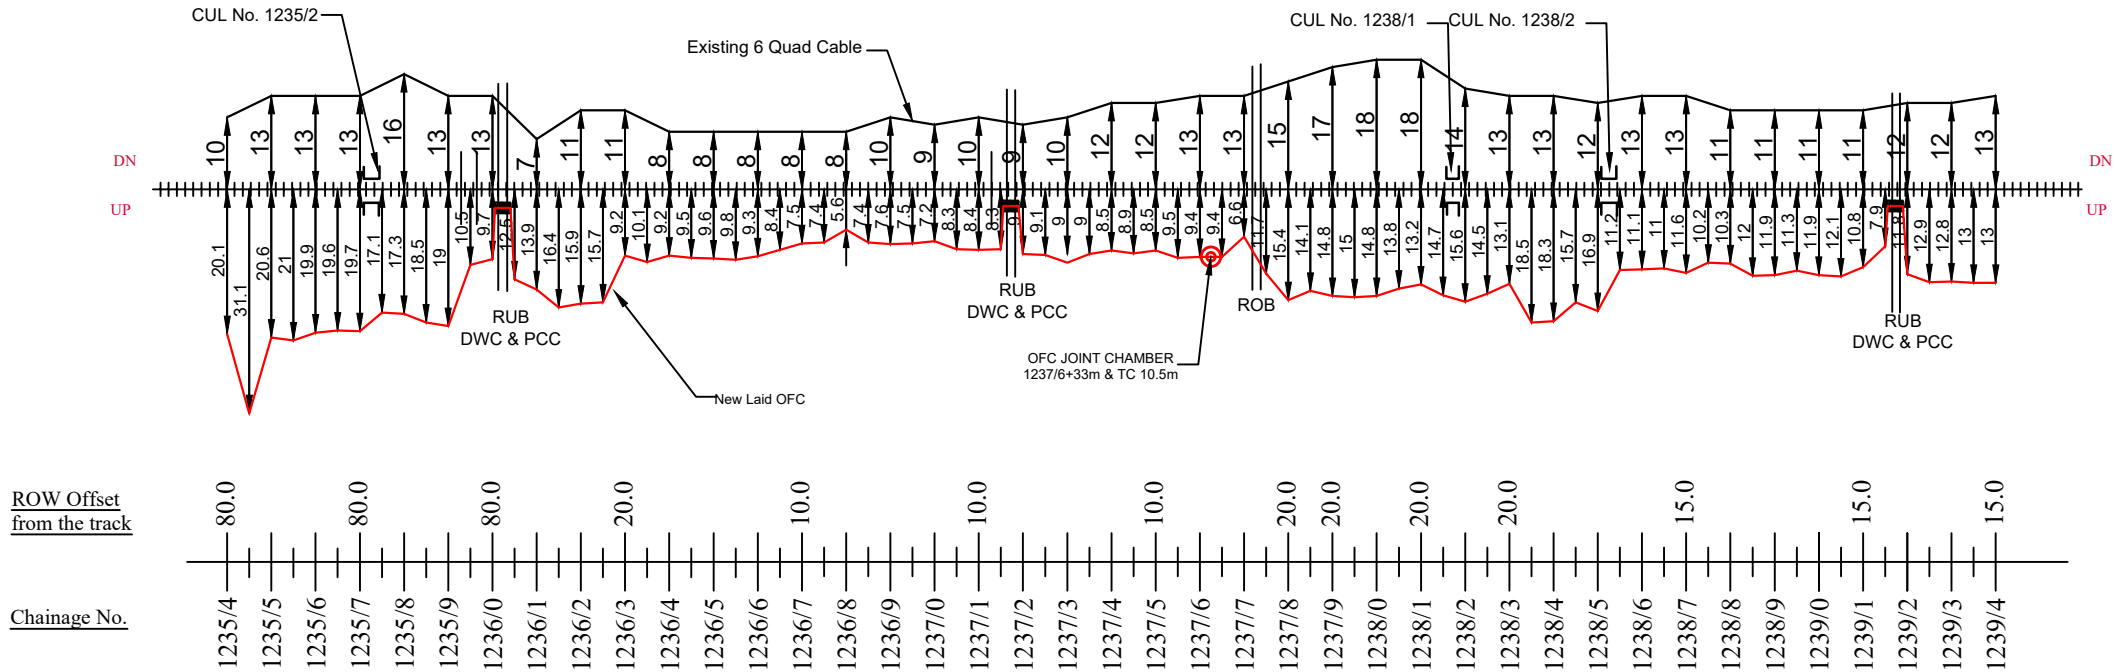

LEGENDS

RAILWAY LINE	=====
NEW LAID OFC	—
OFC JOINT CHAMBER	—
LIMITED HIEGHT SUBWAY	==
LC GATE/ LX GATE	—
CULVERT/BRIDGE	—
DWC & PCC	—
EXISTING 6 QUAD CABLE	—

BABA PROJECTS
PVT. LTD.

DRAWN BY:-
Naval Kishor Singh

CHECKED BY:-

NORTH CENTRAL
RAILWAY

OFC ROUTE DIAGRAM
FOR THE ROUTE
GWALIOR TO ETAWAH

ALL DIMENSION ARE IN METER
(NOT TO SCALE)

APPROVED BY RAILWAYS

Dy. CSTE/NCRPU/ALJN

ASTE/NCRPU/ALJN


SSE/T/PU/CNB

As Built diagram of 24F from BIRLANAGAR Stn. TO SANICHARA Stn.

SHEET NO. 5 of 6

BLNR

SAC

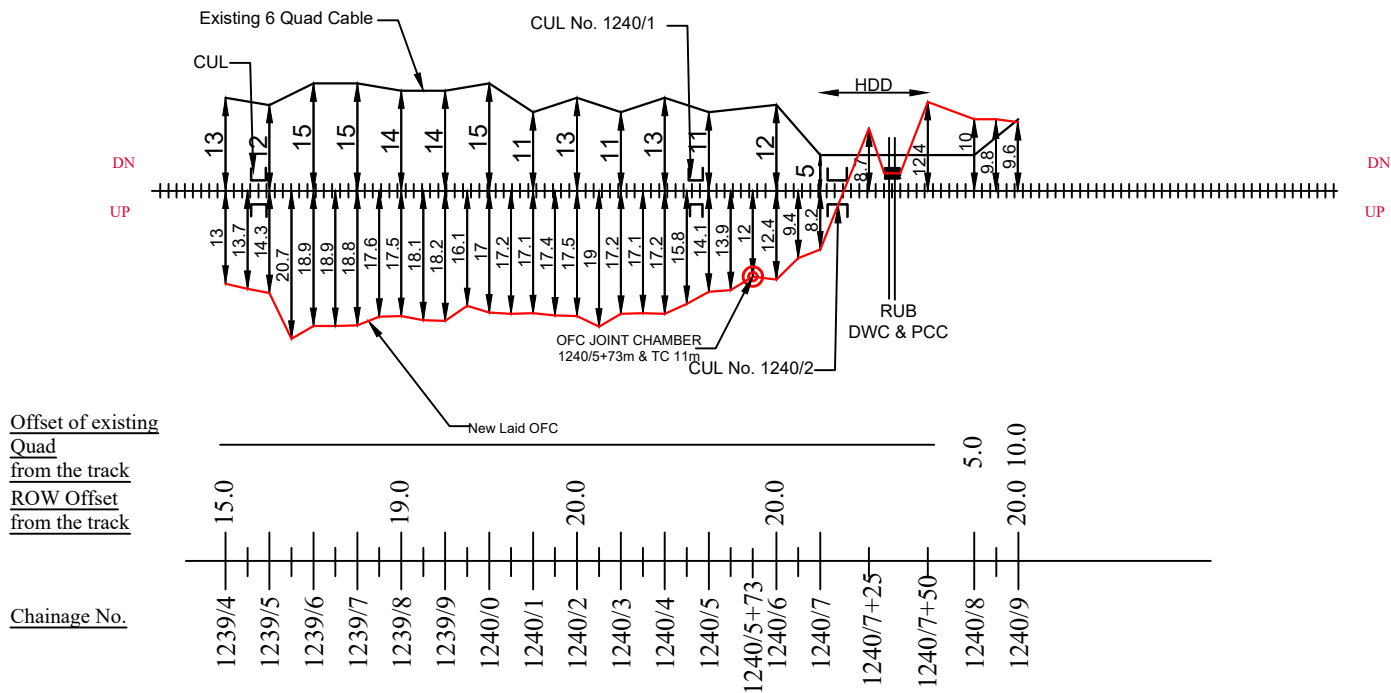

LEGENDS


RAILWAY LINE	+++++
NEW LAID OFC	—
OFC JOINT CHAMBER	⊙
LIMITED HEIGHT SUBWAY	
LC GATE/ LX GATE	⌈ ⌋
CULVERT/BRIDGE	⌈ ⌋
DWC & PCC	⌈ ⌋
EXISTING 6 QUAD CABLE	—

BABA PROJECTS PVT. LTD.	
DRAWN BY:- Naval Kishor Singh	CHECKED BY:-
ALL DIMENSION ARE IN METER (NOT TO SCALE)	

NORTH CENTRAL RAILWAY
OFC ROUTE DIAGRAM FOR THE ROUTE GWALIOR TO ETAWAH

APPROVED BY RAILWAYS		
Dy. CSTE/NCRPU/ALJN	ASTE/NCRPU/ALJN	SSE/T/PU/CNB

As Built diagram of 24F from BIRLANAGAR Stn. TO SANICHARA Stn.
STATION - SHANICHARA (YARD)

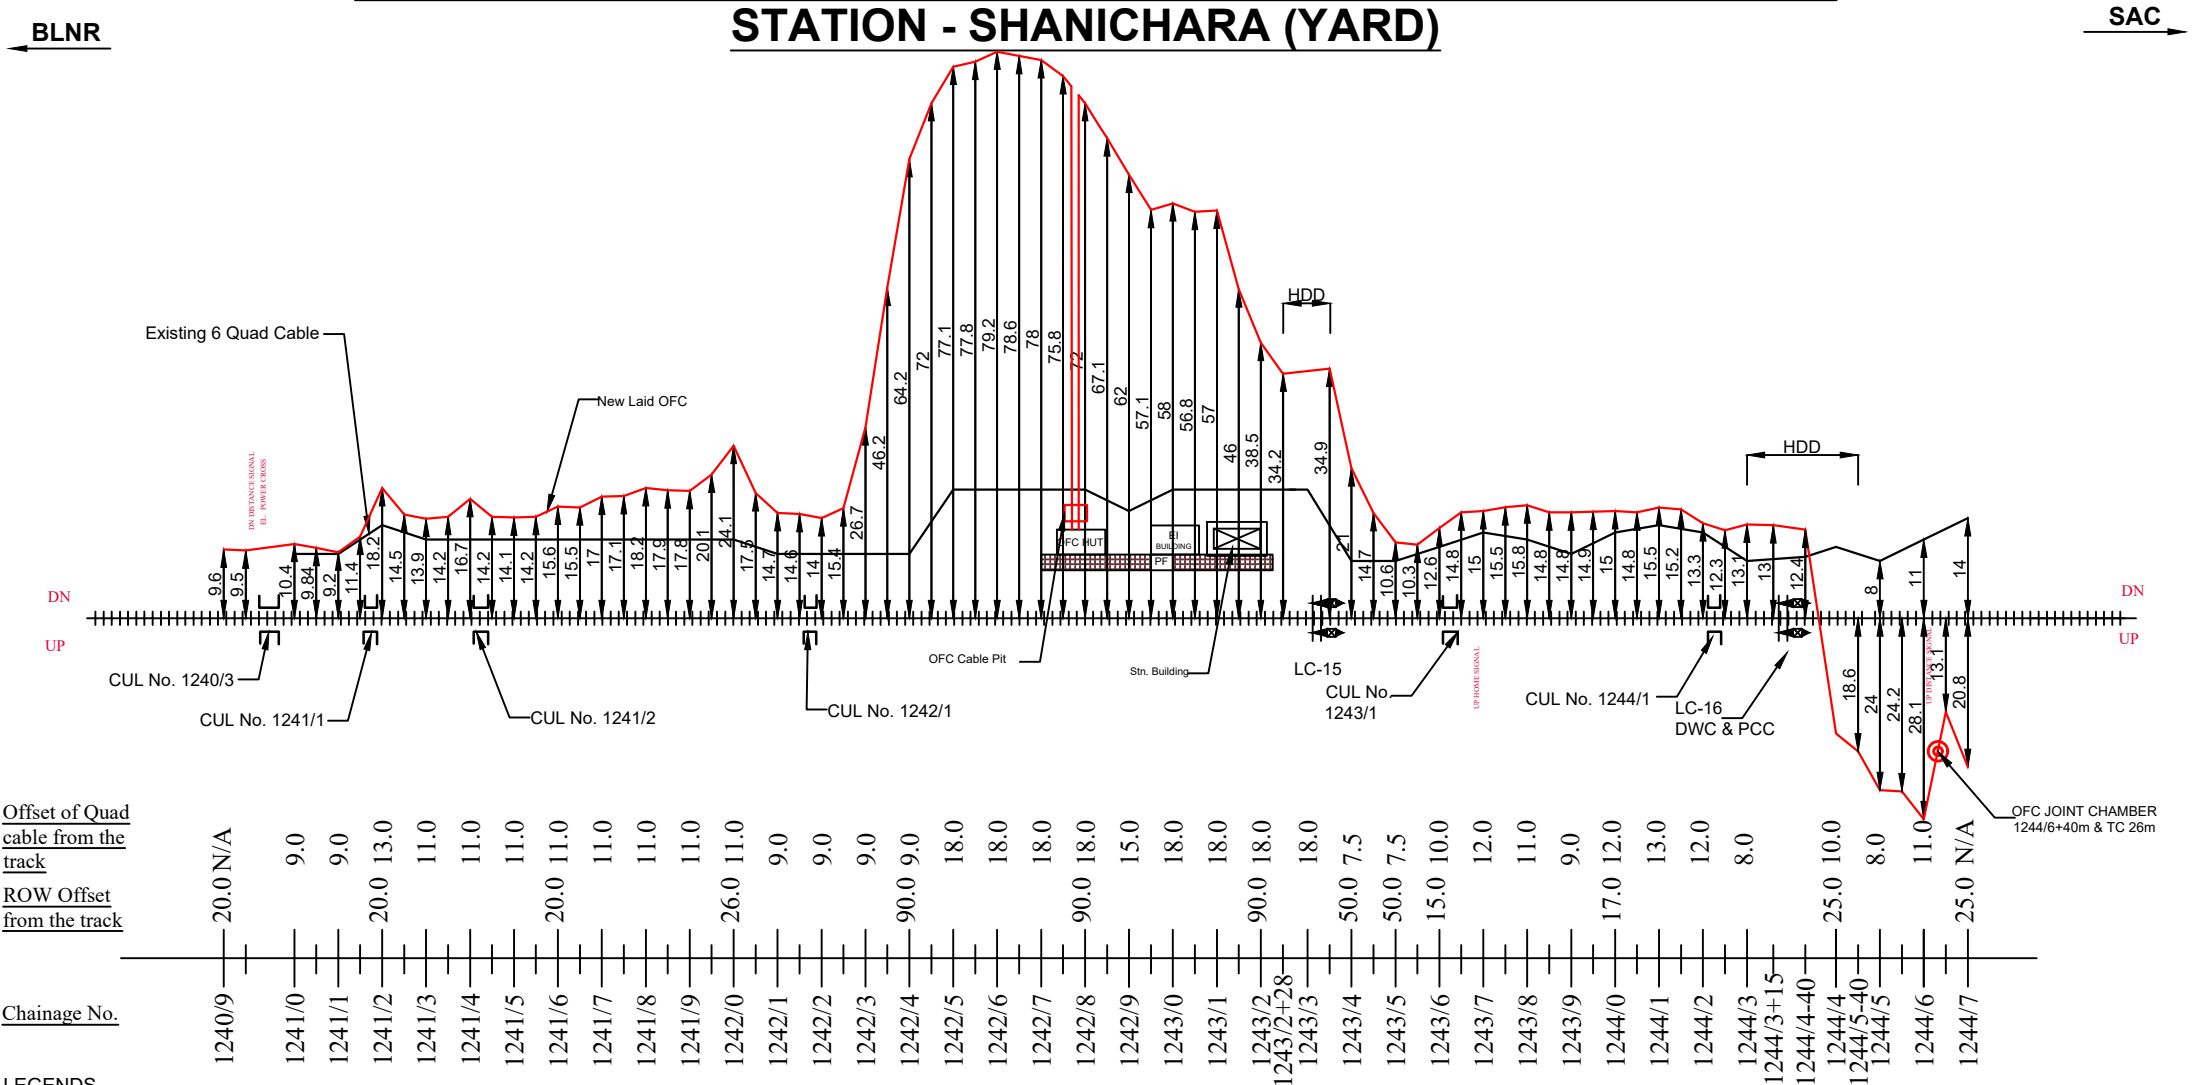

LEGENDS

STATION BUILDING	
OFC CABLE PIT	
RAILWAY LINE	
NEW LAID OFC	
OFC JOINT CHAMBER	
LIMITED HIEGHT SUBWAY	
LC GATE/ LX GATE	
CULVERT/BRIDGE	
DWC & PCC	
EXISTING 6 QUAD CABLE	

BABA PROJECTS PVT. LTD.	
DRAWN BY:-	CHECKED BY:-
Naval Kishor Singh	
ALL DIMENSION ARE IN METER (NOT TO SCALE)	

NORTH CENTRAL RAILWAY
OFC ROUTE DIAGRAM FOR THE ROUTE GWALIOR TO ETAWAH

APPROVED BY RAILWAYS		
Dy. CSTE/NCRPU/ALJN	ASTE/NCRPU/ALJN	SSE/T/PU/CNB