



NORTH CENTRAL RAILWAY

JHANSI DIVISION

AS BUILT DIAGRAM OF 24 FIBER CABLE

SUB-SECTIONS :- **SHANICHARA Stn. TO MALANPUR Stn.**

DRAWN BY:-

BABA PROJECTS PVT. LTD.

2K/74, BARIATU HOUSING COLONY,

BARIATU, RANCHI-9, JHARKHAND


email :- bppl@bppl.org

As Built Diagram of 24F from SANICHARA Stn. TO MALANPUR Stn.

SHEET NO. 1 of 2

SAC

MLAR

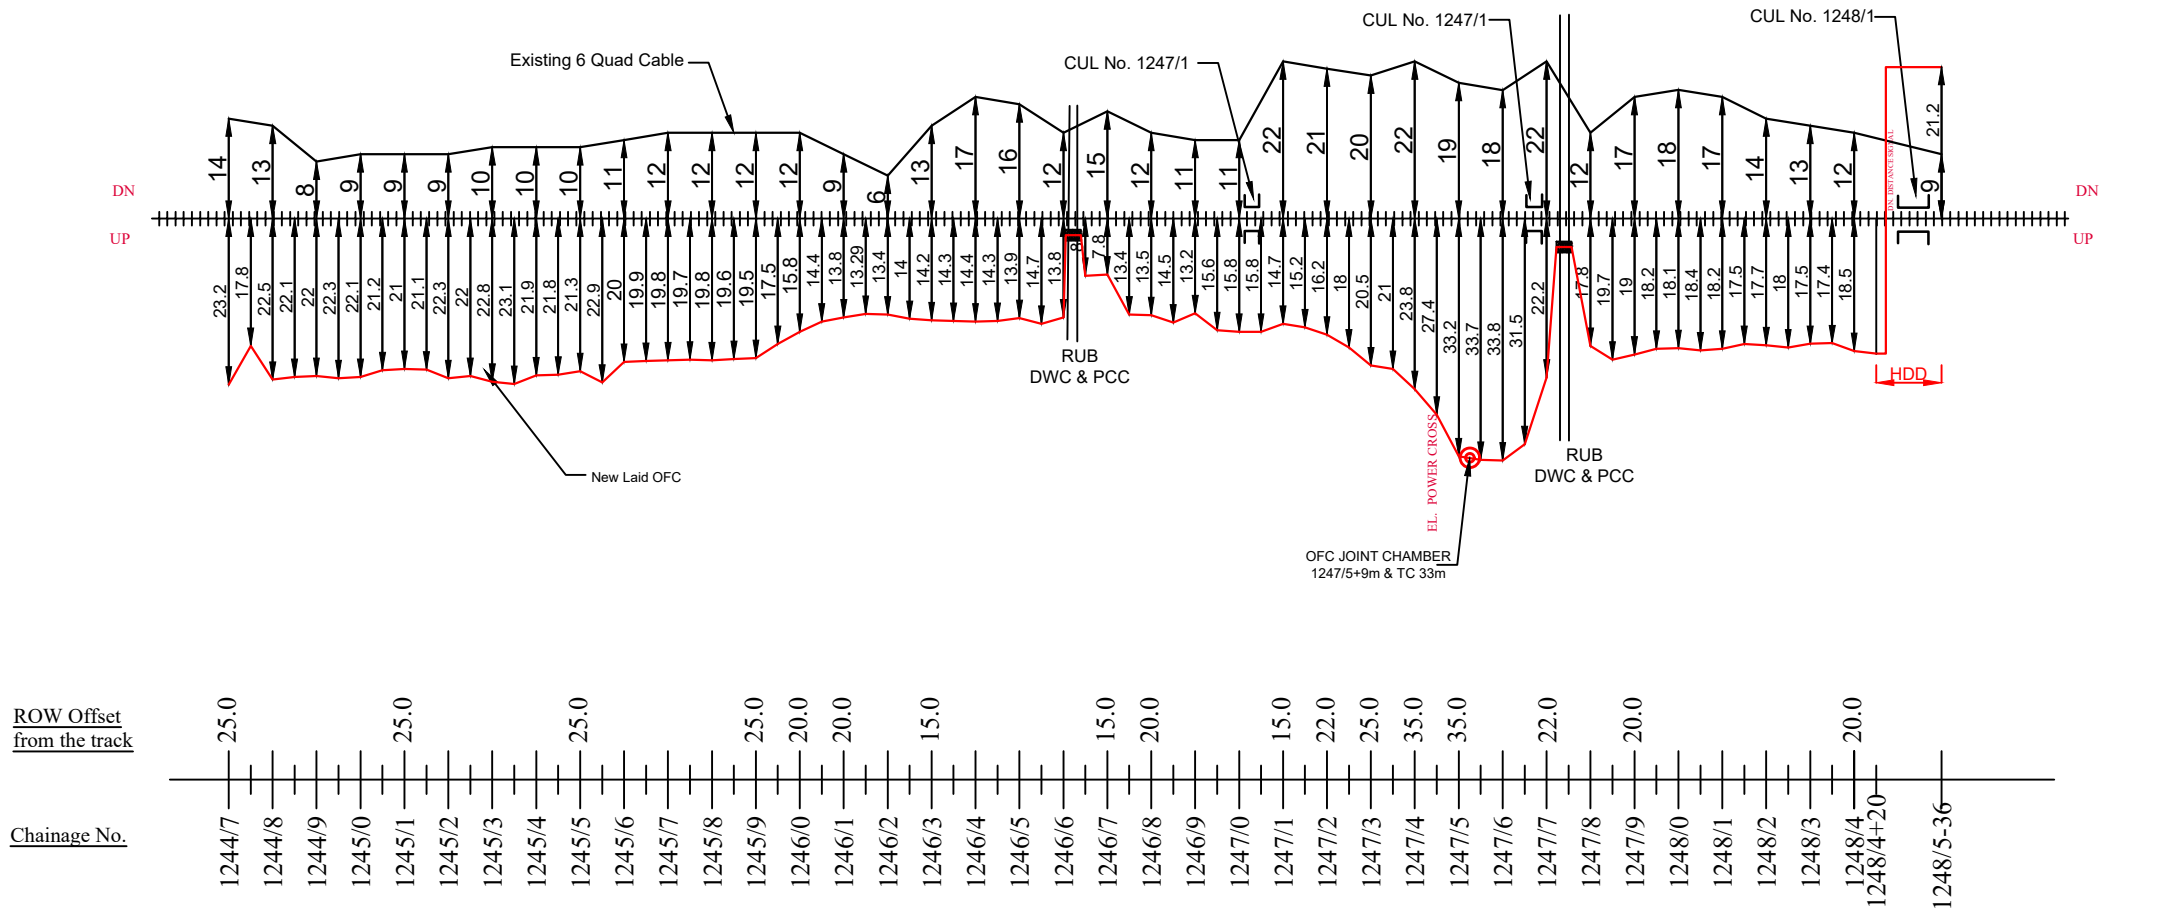

LEGENDS

RAILWAY LINE	=====
NEW LAID OFC	=====
OFC JOINT CHAMBER	⊙
LIMITED HEIGHT SUBWAY	==
LC GATE/ LX GATE	⬆️⬆️
CULVERT/BRIDGE	⌈ ⌋
DWC & PCC	⌈ ⌋
EXISTING 6 QUAD CABLE	=====

NORTH CENTRAL RAILWAY

BABA PROJECTS PVT. LTD.

APPROVED BY RAILWAYS

OFC ROUTE DIAGRAM FOR THE ROUTE GWALIOR TO ETAWAH

DRAWN BY:-
Naval Kishor Singh

CHECKED BY:-

ALL DIMENSION ARE IN METER (NOT TO SCALE)

Dy. CSTE/NCRPU/ALJN

ASTE/NCRPU/ALJN

SSE/T/PU/CNB


As Built Diagram of 24F from SANICHARA Stn. TO MALANPUR Stn.

STATION - MALANPUR (YARD AREA)

SHEET NO. 2 of 2

SAC

GOA

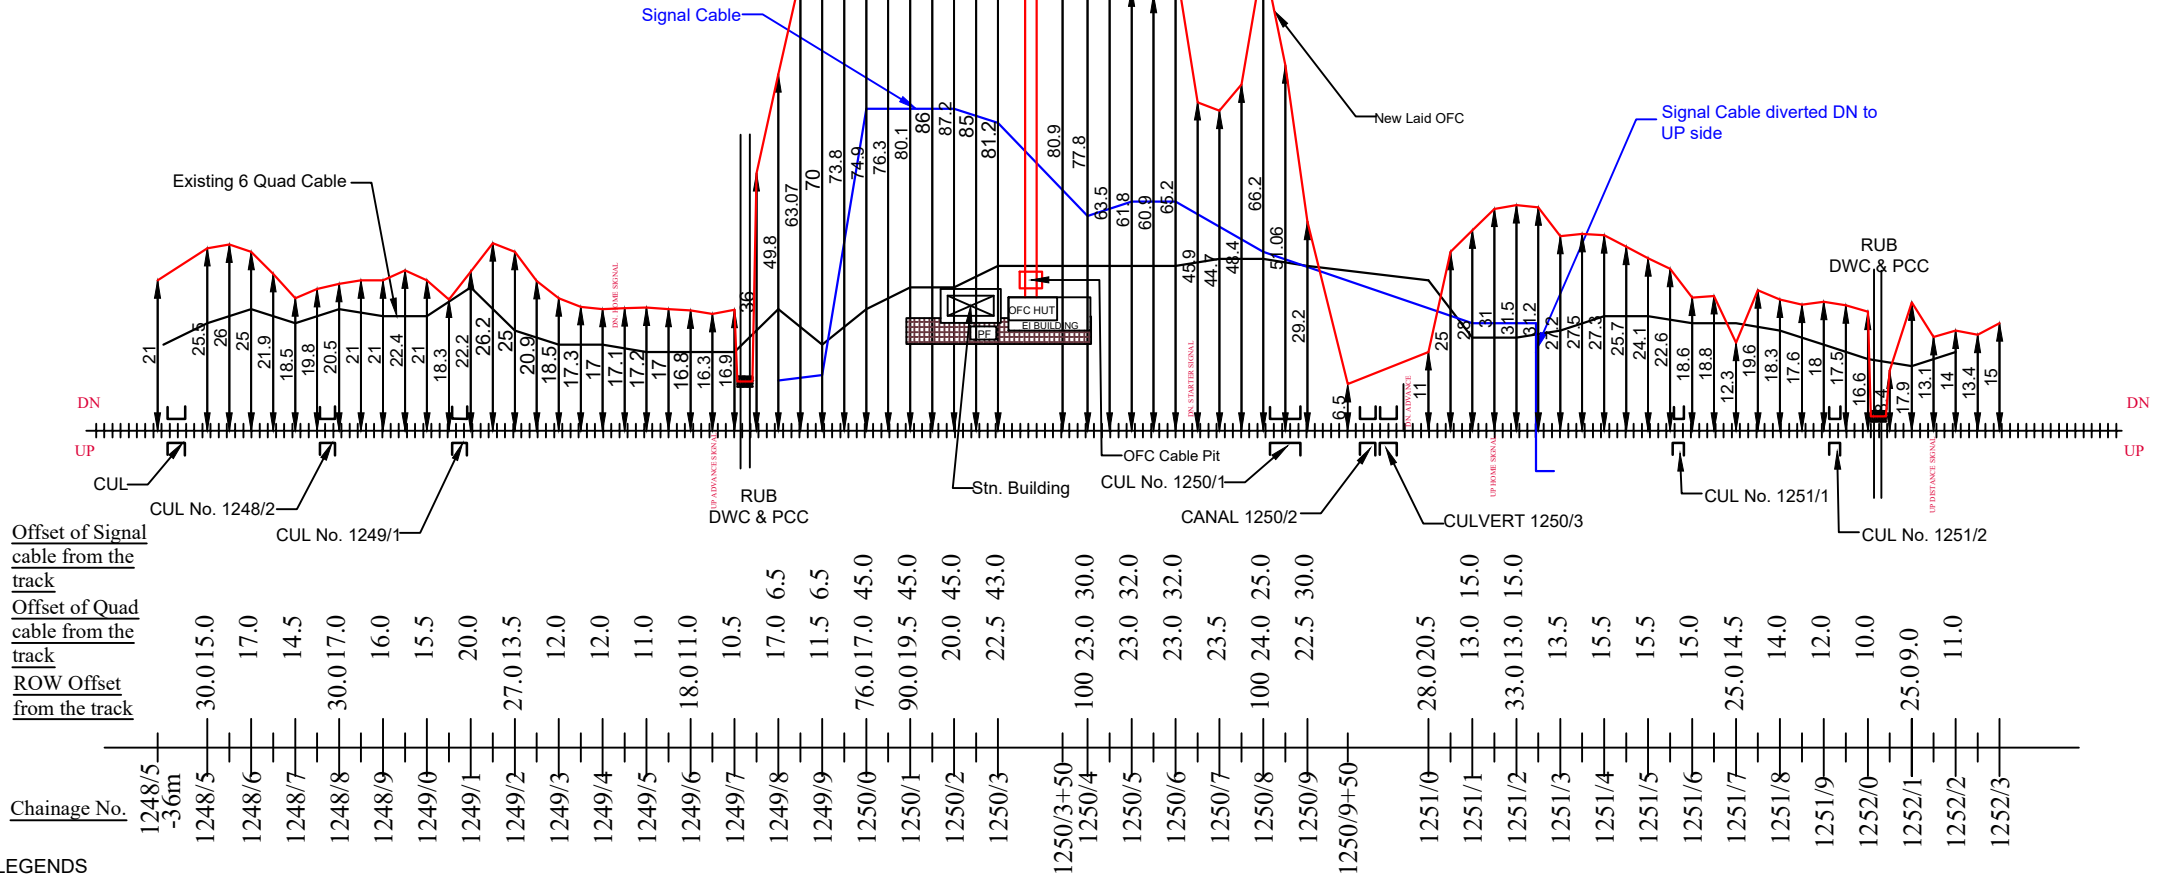

LEGENDS

STATION BUILDING	
OFC CABLE PIT	
RAILWAY LINE	
NEW LAID OFC	
OFC JOINT CHAMBER	
LIMITED HEIGHT SUBWAY	
LC GATE/ LX GATE	
CULVERT/BRIDGE	
DWC & PCC	
EXISTING 6 QUAD CABLE	

BABA PROJECTS PVT. LTD.	
DRAWN BY:-	CHECKED BY:-
Naval Kishor Singh	
ALL DIMENSION ARE IN METER (NOT TO SCALE)	

NORTH CENTRAL RAILWAY
OFC ROUTE DIAGRAM FOR THE ROUTE GWALIOR TO ETAWAH

APPROVED BY RAILWAYS		
Dy. CSTE/NCRPU/ALJN	ASTE/NCRPU/ALJN	SSE/T/PU/CNB

Note: - Existing Signal cable is laid in UP side.