



NORTH CENTRAL RAILWAY

JHANSI DIVISION

AS BUILT DIAGRAM OF 24 FIBER CABLE

SUB-SECTIONS :- **GOHAD ROAD Stn. TO SONI Stn.**

DRAWN BY:-

BABA PROJECTS PVT. LTD.

2K/74, BARIATU HOUSING COLONY,

BARIATU, RANCHI-9, JHARKHAND


email :- bppl@bppl.org

As Built Diagram of 24F from GOHAD ROAD Stn. TO SONI Stn.

SHEET NO. 1 of 4


MLAR

SONI

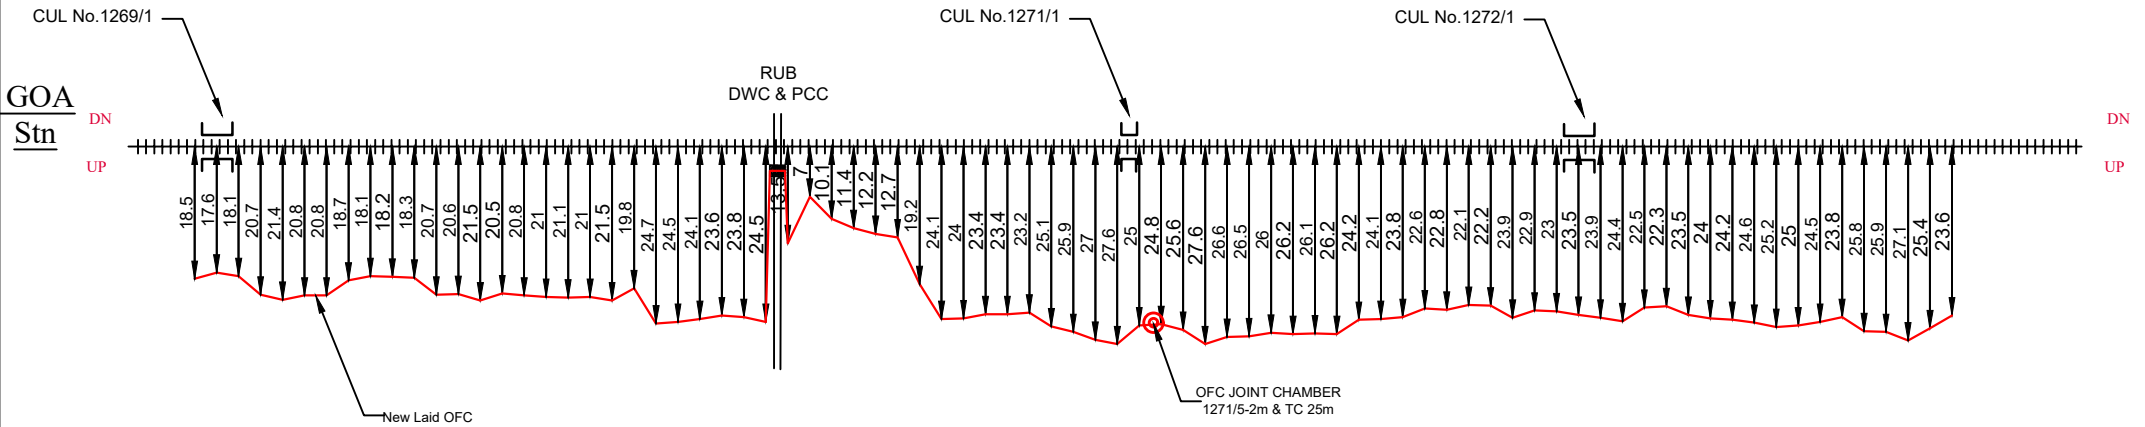

ROW Offset
from the track

Chainage No.

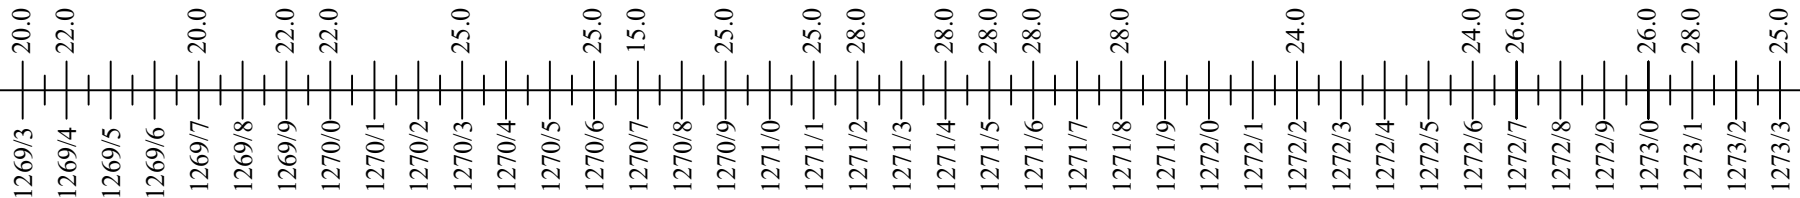

LEGENDS

RAILWAY LINE	=====
NEW LAID OFC	—
OFC JOINT CHAMBER	⊙
LIMITED HEIGHT SUBWAY	
LC GATE/ LX GATE	⬆⬇⬆
CULVERT/BRIDGE	[]
DWC & PCC	[]
EXISTING 6 QUAD CABLE	—

BABA PROJECTS PVT. LTD.	
DRAWN BY:- <i>Naval Kishor Singh</i>	CHECKED BY:-
ALL DIMENSION ARE IN METER (NOT TO SCALE)	

NORTH CENTRAL RAILWAY
OFC ROUTE DIAGRAM FOR THE ROUTE GWALIOR TO ETAWAH

APPROVED BY RAILWAYS		
Dy. CSTE/NCRPU/ALJN	ASTE/NCRPU/ALJN	SSE/T/PU/CNB


Note: - Existing Quad cable is laid in DN Side (In opposite side of New laid OFC).

As Built Diagram of 24F from GOHAD ROAD Stn. TO SONI Stn.

SHEET NO. 2 of 4

GOA

SONI

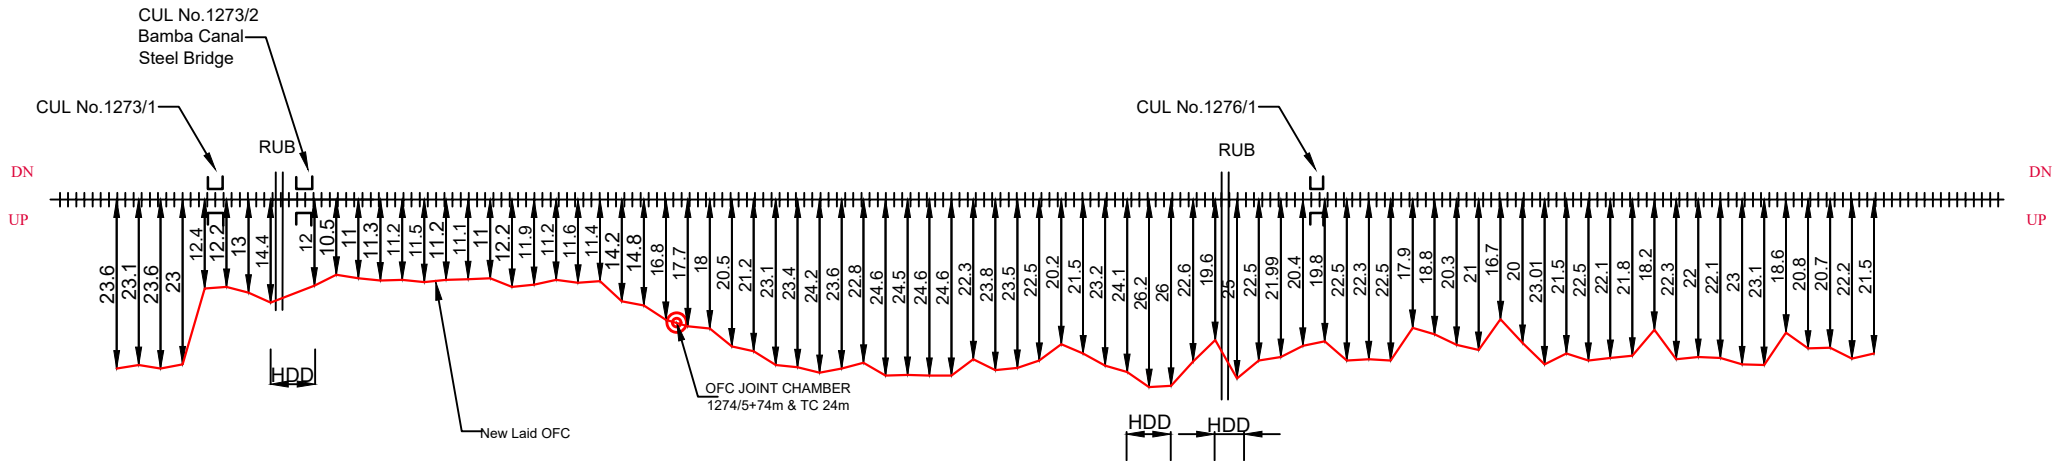

ROW Offset
from the track

Chainage No.

LEGENDS

RAILWAY LINE	=====
NEW LAID OFC	—————
OFC JOINT CHAMBER	⊙
LIMITED HIEGHT SUBWAY	
LC GATE/ LX GATE	⌈ ⌋
CULVERT/BRIDGE	⌈ ⌋
DWC & PCC	⌈ ⌋
EXISTING 6 QUAD CABLE	—————

BABA PROJECTS PVT. LTD.	
DRAWN BY:- <i>Naval Kishor Singh</i>	CHECKED BY:-
ALL DIMENSION ARE IN METER (NOT TO SCALE)	

NORTH CENTRAL RAILWAY
OFC ROUTE DIAGRAM FOR THE ROUTE GWALIOR TO ETAWAH

APPROVED BY RAILWAYS		
Dy. CSTE/NCRPU/ALJN	ASTE/NCRPU/ALJN	SSE/T/PU/CNB


Note: - Existing Quad cable is laid in DN Side (In opposite side of New laid OFC).

As Built Diagram of 24F from GOHAD ROAD Stn. TO SONI Stn.

SHEET NO. 3 of 4


GOA

SONI

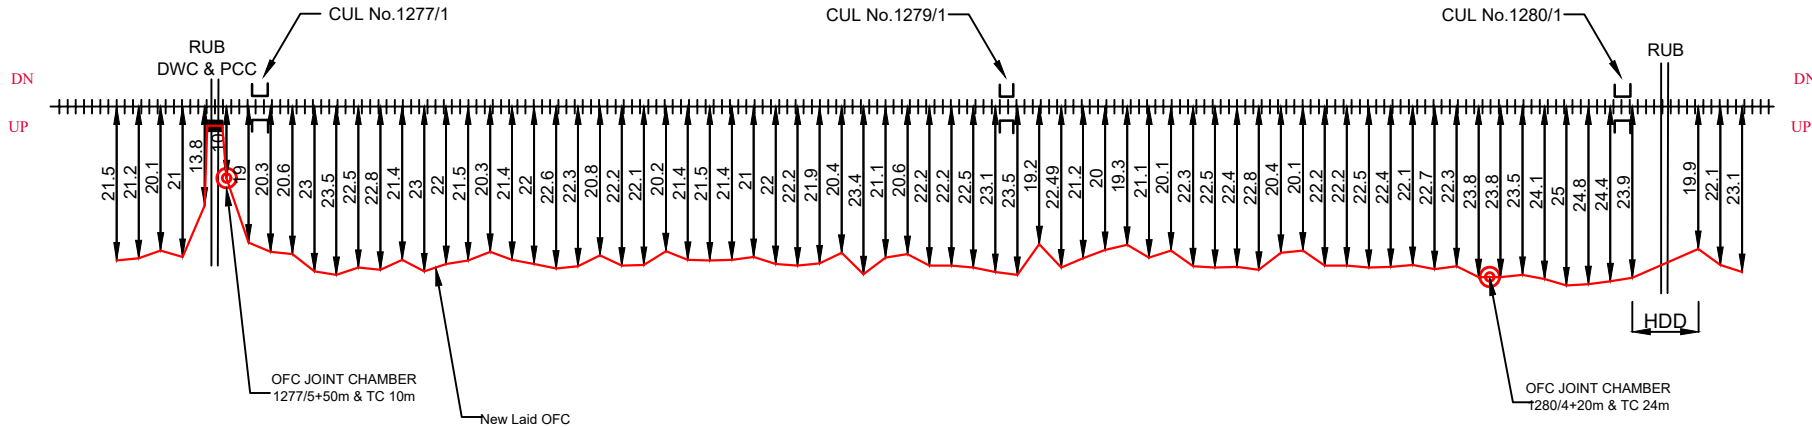

ROW Offset
from the track

Chainage No.

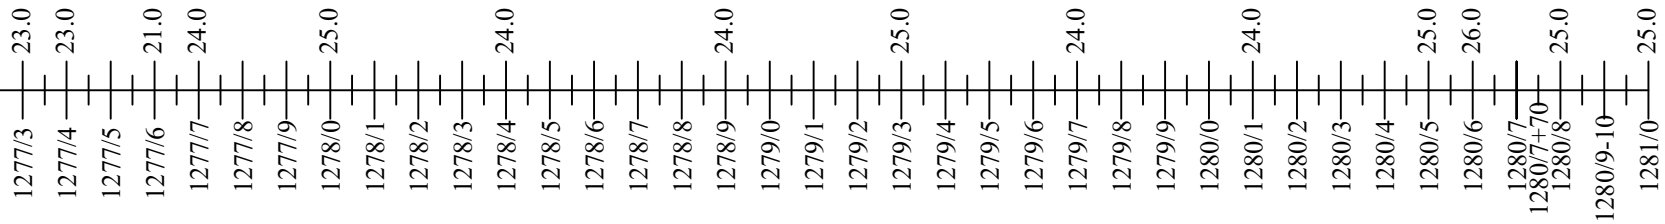

LEGENDS

RAILWAY LINE	=====
NEW LAID OFC	—
OFC JOINT CHAMBER	⊙
LIMITED HEIGHT SUBWAY	
LC GATE/ LX GATE	⌈ ⌋
CULVERT/BRIDGE	⌈ ⌋
DWC & PCC	⌈ ⌋
EXISTING 6 QUAD CABLE	—

BABA PROJECTS PVT. LTD.	
DRAWN BY:-	CHECKED BY:-
Naval Kishor Singh	
ALL DIMENSION ARE IN METER (NOT TO SCALE)	


NORTH CENTRAL RAILWAY
OFC ROUTE DIAGRAM FOR THE ROUTE GWALIOR TO ETAWAH

APPROVED BY RAILWAYS		
Dy. CSTE/NCRPU/ALJN	ASTE/NCRPU/ALJN	SSE/T/PU/CNB


Note: - Existing Quad cable is laid in DN Side (In opposite side of New laid OFC).

GOA

BIX

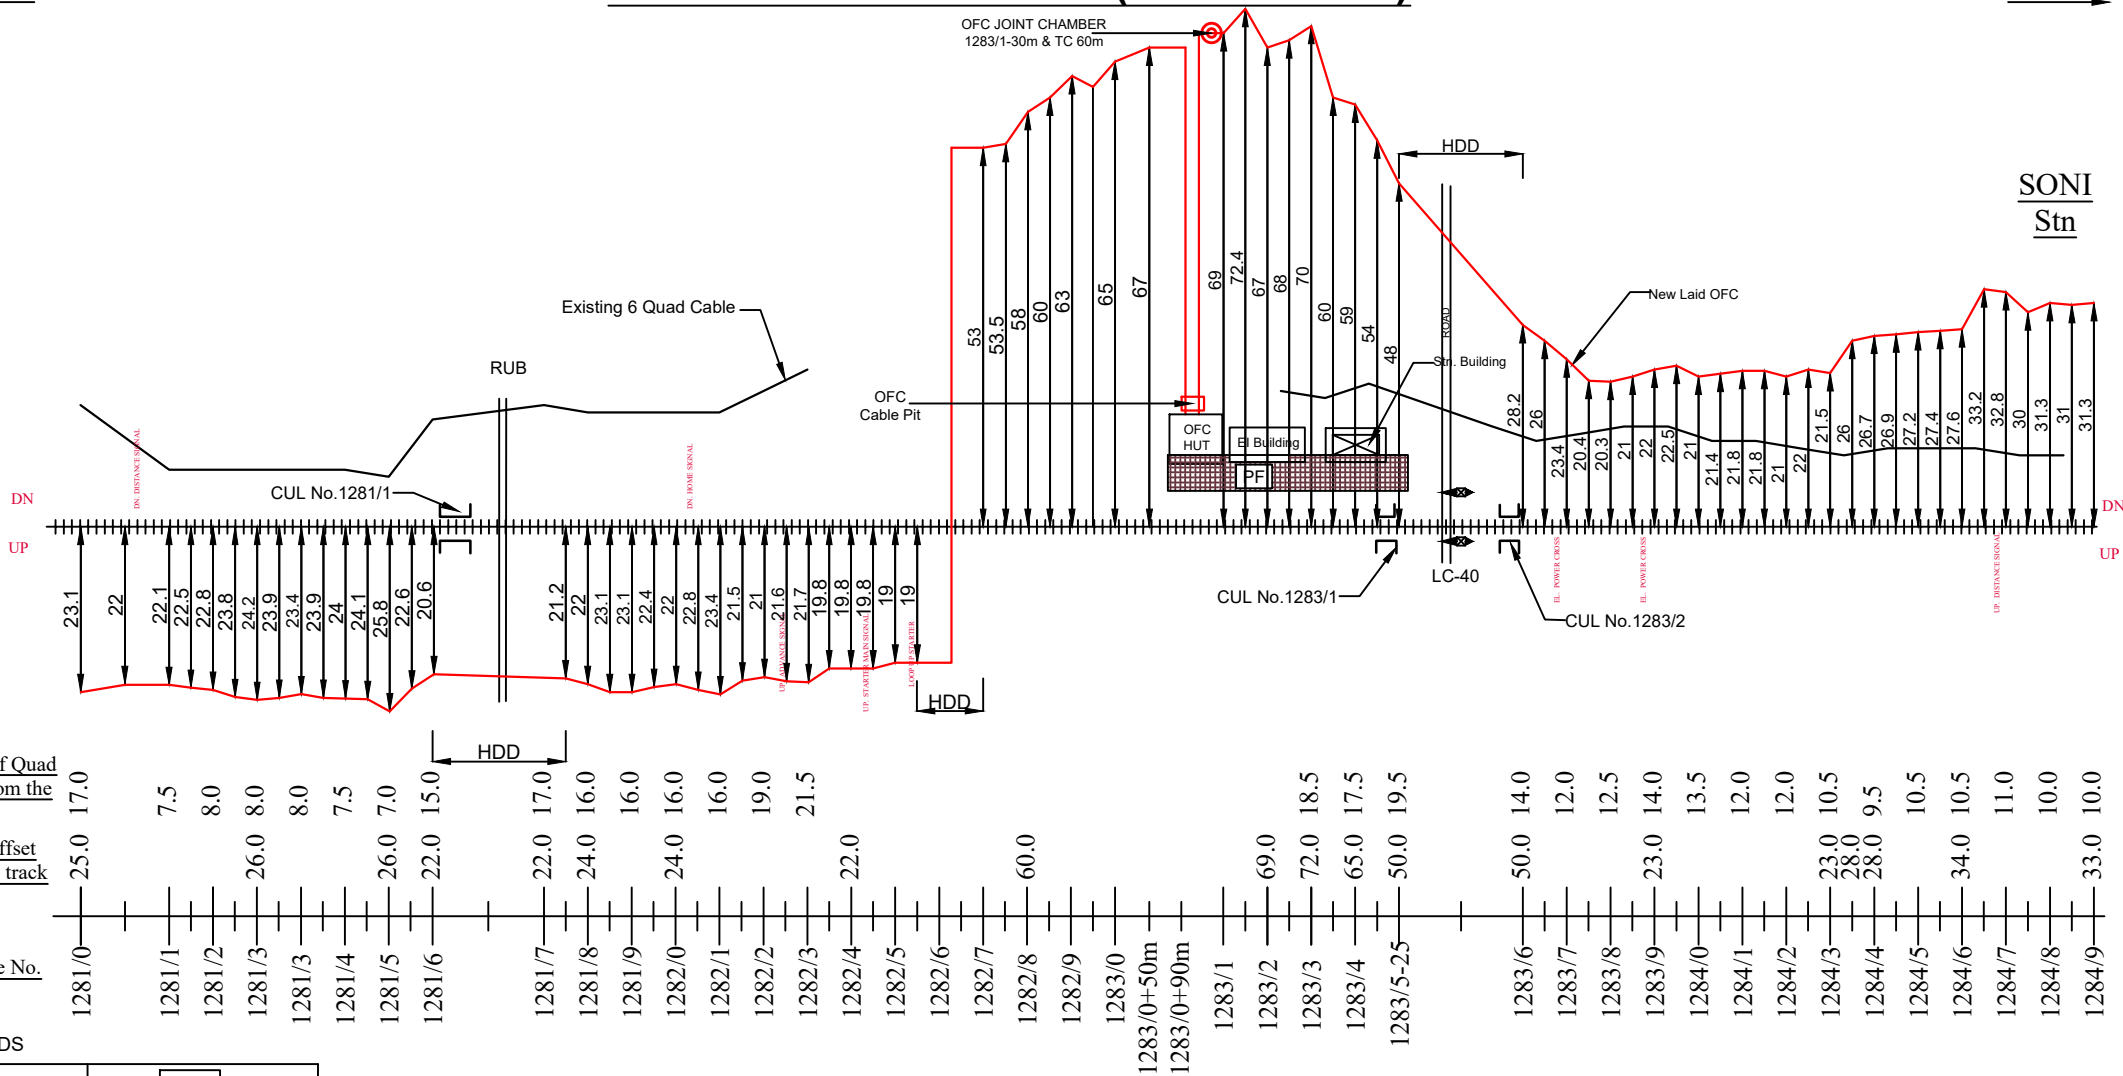

 Note: - Signal Cable is laid in UP Side.

STATION BUILDING		BABA PROJECTS PVT. LTD. DRAWN BY:- <i>Naval Kishor Singh</i> CHECKED BY:- ALL DIMENSION ARE IN METER (NOT TO SCALE)	NORTH CENTRAL RAILWAY OFC ROUTE DIAGRAM FOR THE ROUTE GWALIOR TO ETAWAH	APPROVED BY RAILWAYS		
OFC CABLE PIT				Note: - Signal Cable is laid in UP Side.		
RAILWAY LINE						
NEW LAID OFC						
OFC JOINT CHAMBER						
LIMITED HIEGHT SUBWAY						
LC GATE/ LX GATE						
CULVERT/BRIDGE						
DWC & PCC						
EXISTING 6 QUAD CABLE						
				<u>Dy. CST/ECRPU/ALJN</u>	<u>ASTE/ECRPU/ALJN</u>	<u>SSE/T/PU/CNB</u>