



NORTH CENTRAL RAILWAY

JHANSI DIVISION

AS BUILT DIAGRAM OF 24 FIBER CABLE

SUB-SECTIONS :- [SONI Stn.TO BHIND Stn.](#)

DRAWN BY:-

BABA PROJECTS PVT. LTD.

2K/74, BARIATU HOUSING COLONY,

BARIATU, RANCHI-9, JHARKHAND


email :- bppl@bppl.org

As Built Diagram of 24F from SONI Stn. TO BHIND Stn.

SHEET NO. 1 of 5


SONI

BHIND

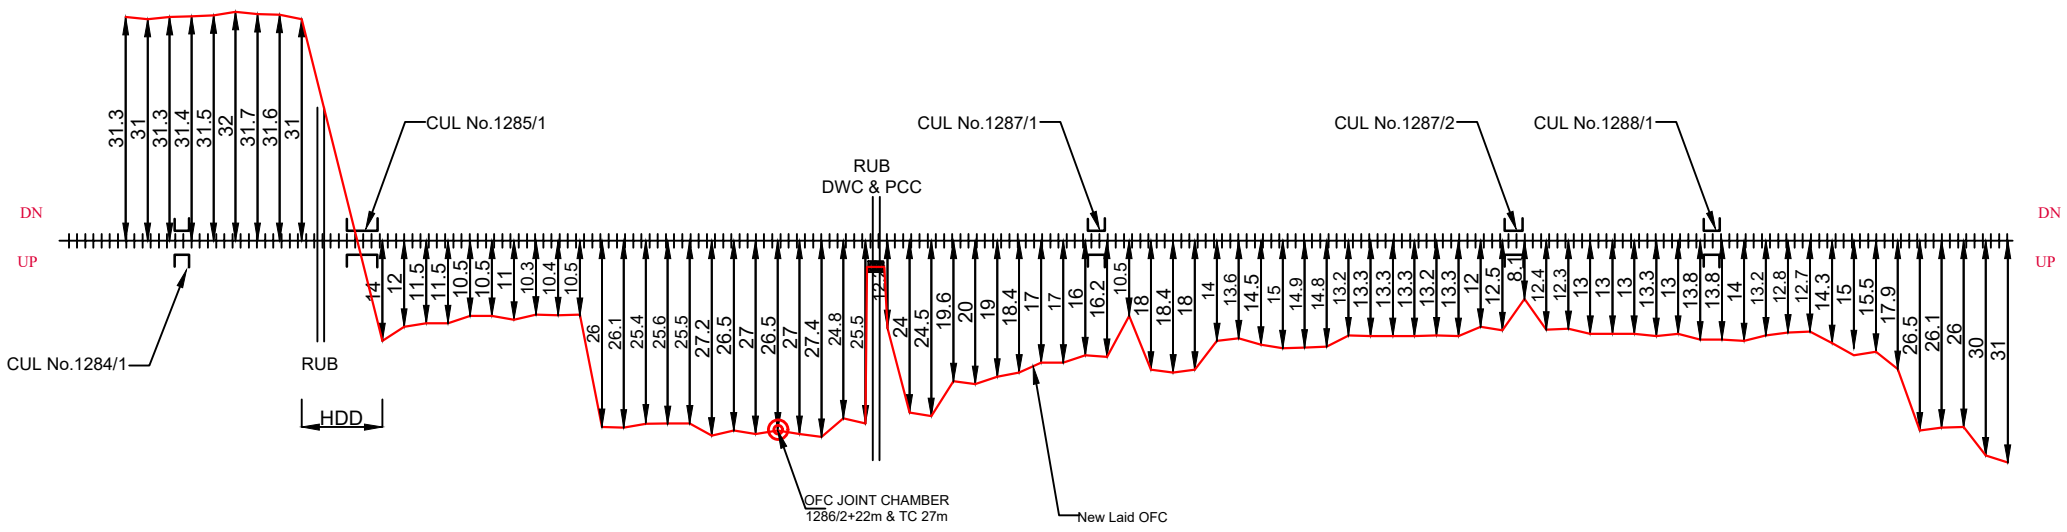

ROW Offset
from the track

Chainage No.

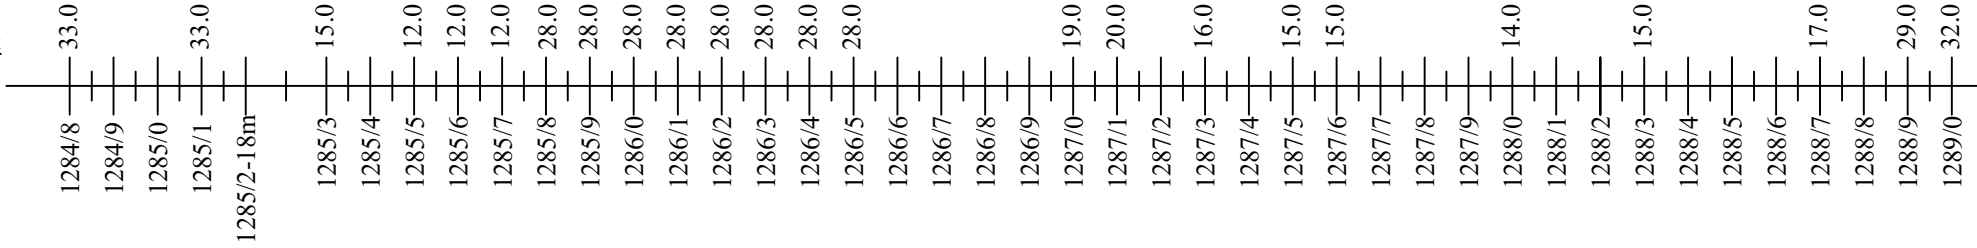

LEGENDS

RAILWAY LINE	=====
NEW LAID OFC	-----
OFC JOINT CHAMBER	-----
LIMITED HEIGHT SUBWAY	=====
LC GATE/ LX GATE	=====
CULVERT/BRIDGE	=====
DWC & PCC	=====
EXISTING 6 QUAD CABLE	-----

NORTH CENTRAL
RAILWAY

BABA PROJECTS
PVT. LTD.

APPROVED BY RAILWAYS

OFC ROUTE DIAGRAM
FOR THE ROUTE
GWALIOR TO ETAWAH

DRAWN BY:- <i>Naval Kishor Singh</i>	CHECKED BY:-
---	--------------

ALL DIMENSION ARE IN METER
(NOT TO SCALE)

Note: - Existing 6 Quad cable is laid towards DN side.

Dy. CSTE/NCRPU/ALJN


ASTE/NCRPU/ALJN

SSE/T/PU/CNB

As Built Diagram of 24F from SONI Stn. TO BHIND Stn.

SONI

BHIND

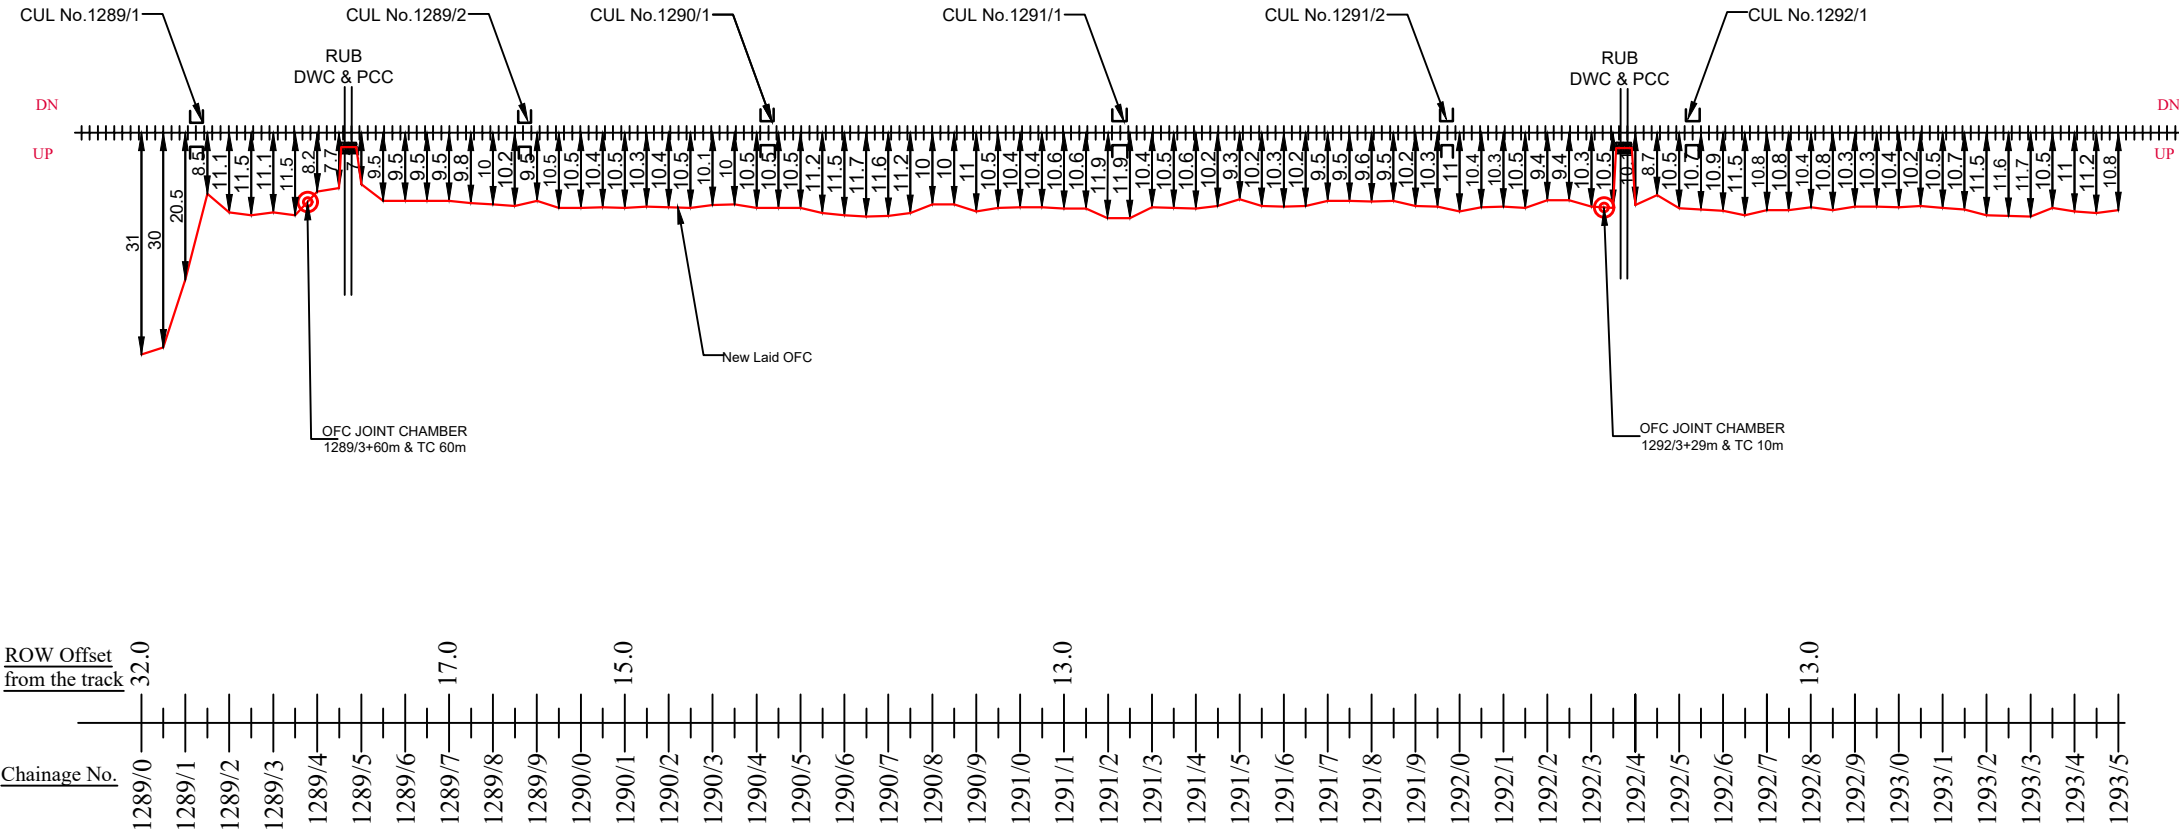

LEGENDS

RAILWAY LINE	+++++
NEW LAID OFC	—
OFC JOINT CHAMBER	⊙
LIMITED HIEGHT SUBWAY	
LC GATE/ LX GATE	⌈ ⌋
CULVERT/BRIDGE	⌈ ⌋
DWC & PCC	⌈ ⌋
EXISTING 6 QUAD CABLE	—

NORTH CENTRAL
RAILWAY

OFC ROUTE DIAGRAM
FOR THE ROUTE
GWALIOR TO ETAWAH

BABA PROJECTS
PVT. LTD.

DRAWN BY:-
Naval Kishor Singh

CHECKED BY:-

ALL DIMENSION ARE IN METER
(NOT TO SCALE)

Note: - Existing 6 Quad cable is laid towards DN side.

APPROVED BY RAILWAYS

Dy. CSTE/NCRPU/ALJN


ASTE/NCRPU/ALJN

SSE/T/PU/CNB

As Built Diagram of 24F from SONI Stn. TO BHIND Stn.

SONI

BHIND

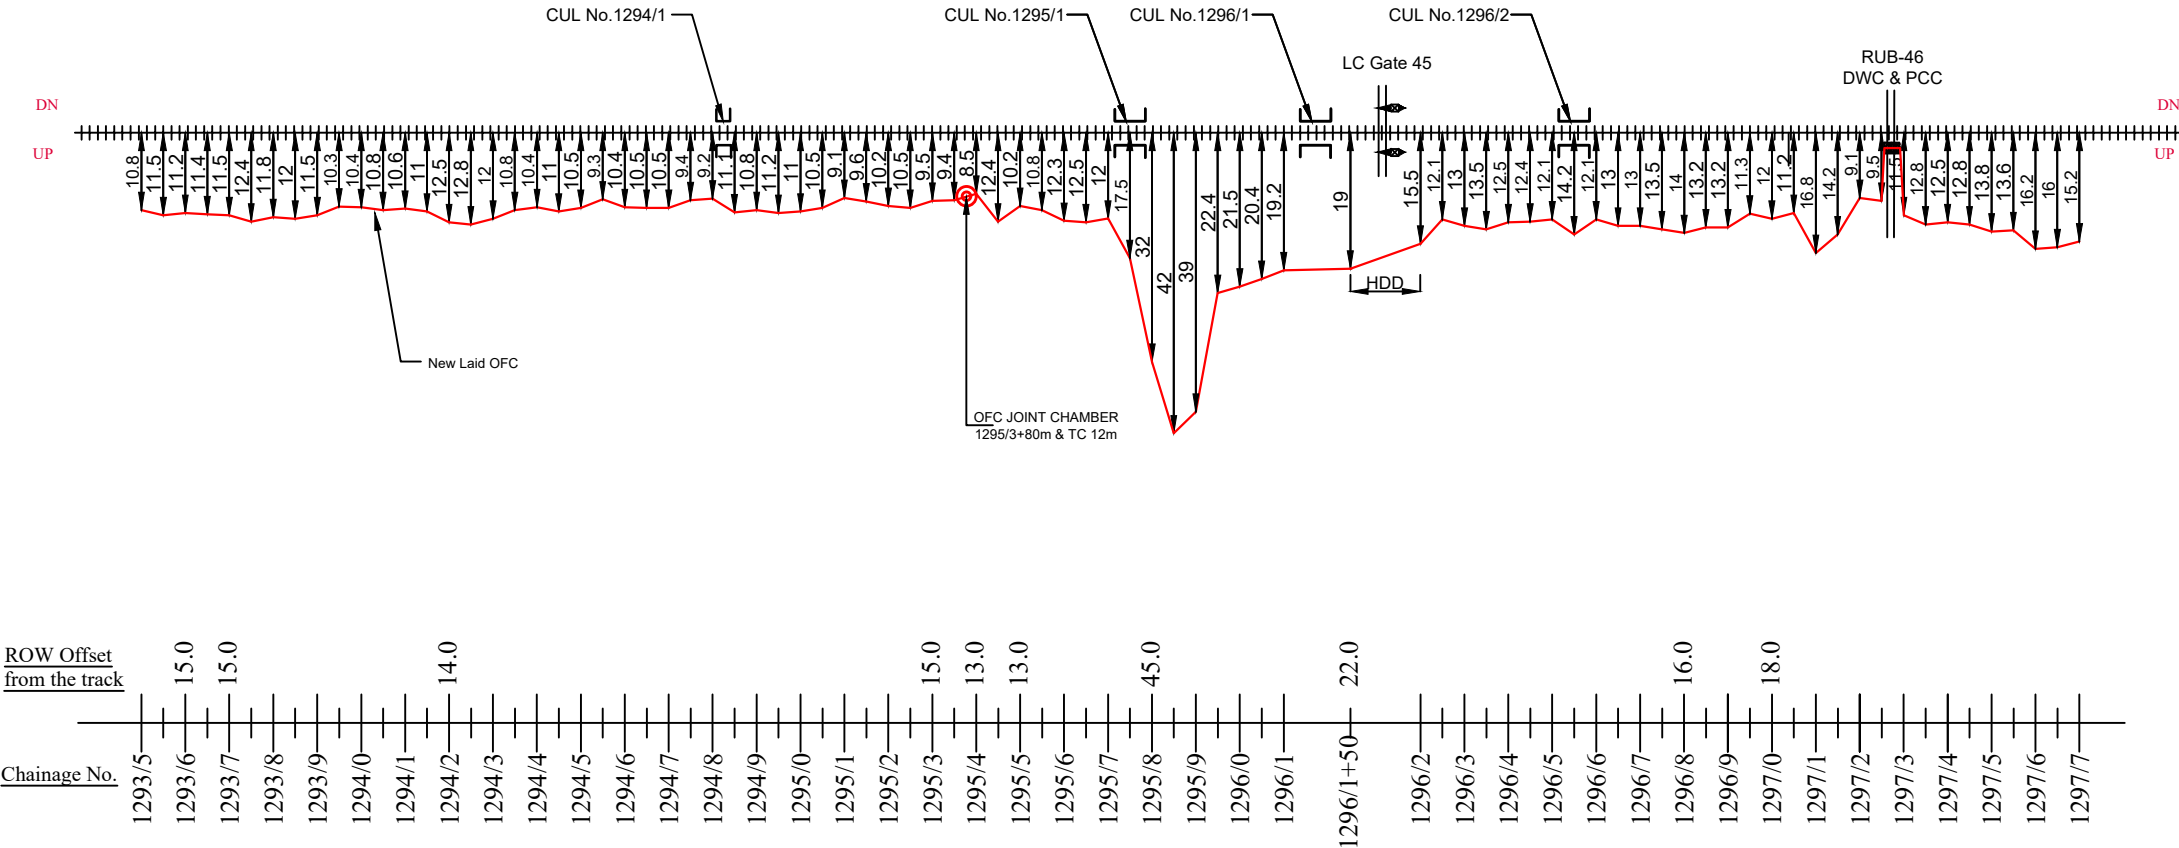

ROW Offset
from the track

Chainage No.

LEGENDS

RAILWAY LINE	+++++
NEW LAID OFC	—
OFC JOINT CHAMBER	⊙
LIMITED HIEGHT SUBWAY	
LC GATE/ LX GATE	⌈ ⌋
CULVERT/BRIDGE	⌈ ⌋
DWC & PCC	⌈ ⌋
EXISTING 6 QUAD CABLE	—

NORTH CENTRAL
RAILWAY

OFC ROUTE DIAGRAM
FOR THE ROUTE
Gwalior to Etawah

BABA PROJECTS
PVT. LTD.

<u>DRAWN BY:-</u> Naval Kishor Singh	<u>CHECKED BY:-</u>
ALL DIMENSION ARE IN METER (NOT TO SCALE)	

Note: - Existing 6 Quad cable is laid towards DN side.

APPROVED BY RAILWAYS

Dy. CSTE/NCRPU/ALJN


ASTE/NCRPU/ALJN

SSE/T/PU/CNB

As Built Diagram of 24F from SONI Stn. TO BHIND Stn.

SONI

BHIND

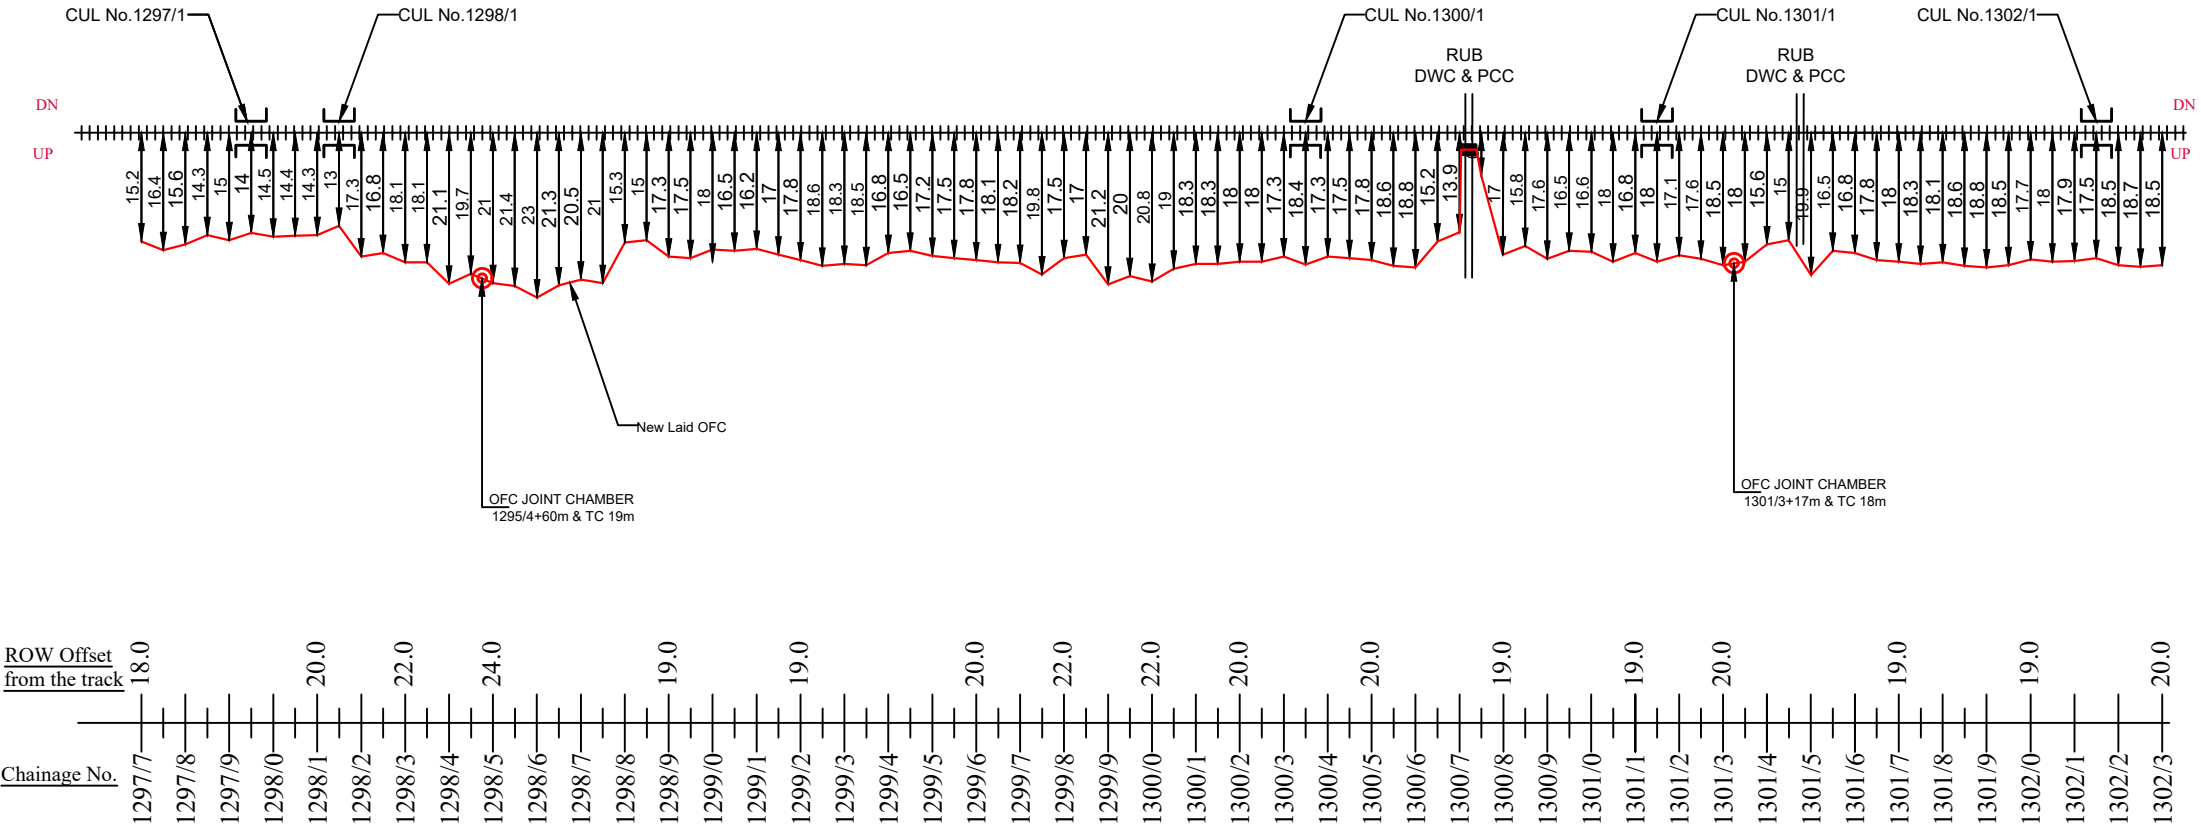

LEGENDS

RAILWAY LINE	+++++
NEW LAID OFC	—
OFC JOINT CHAMBER	⊙
LIMITED HIEGHT SUBWAY	
LC GATE/ LX GATE	⏏
CULVERT/BRIDGE	[]
DWC & PCC	[]
EXISTING 6 QUAD CABLE	—

NORTH CENTRAL RAILWAY

OFC ROUTE DIAGRAM FOR THE ROUTE GWALIOR TO ETAWAH

BABA PROJECTS PVT. LTD.

DRAWN BY:- <i>Naval Kishor Singh</i>	CHECKED BY:-
---	--------------

ALL DIMENSION ARE IN METER (NOT TO SCALE)

Note: - Existing 6 Quad cable is laid towards DN side.

APPROVED BY RAILWAYS

Dy. CSTE/NCRPU/ALJN


ASTE/NCRPU/ALJN

SSE/T/PU/CNB

As Built Diagram of 24F from SONI Stn. TO BHIND Stn.

SONI

BHIND

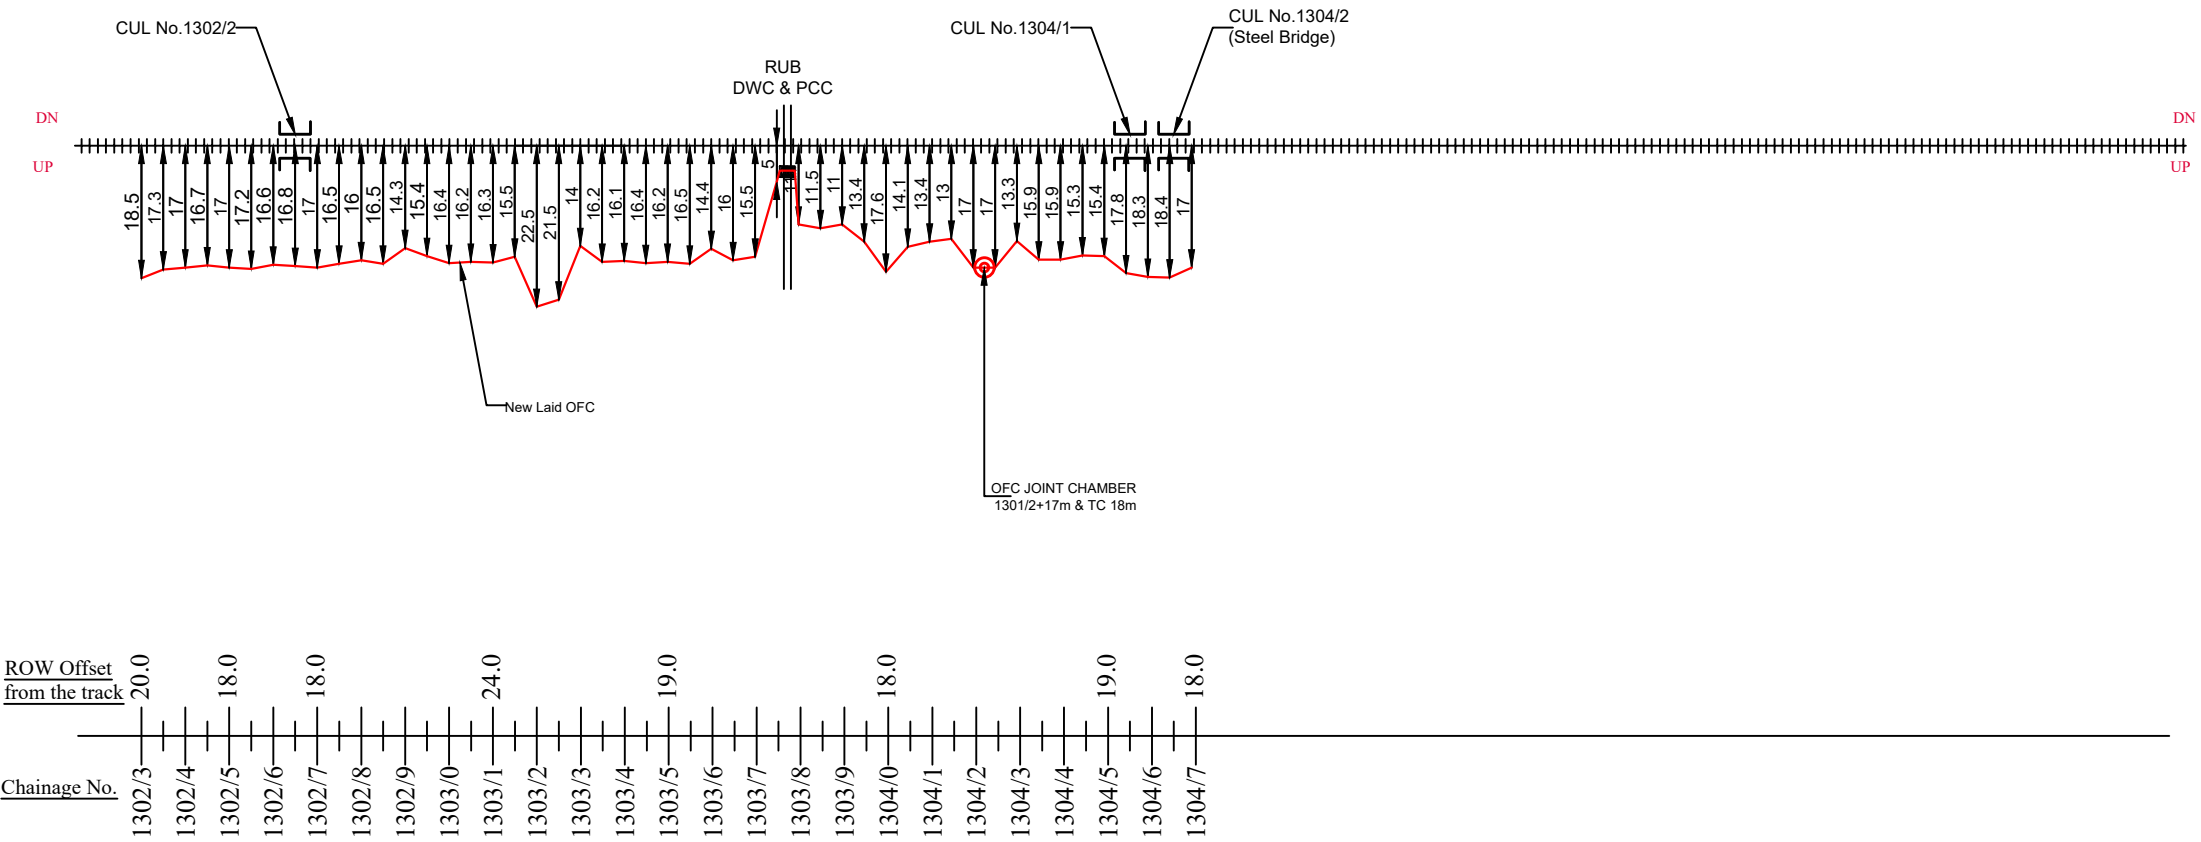

LEGENDS

RAILWAY LINE	+++++
NEW LAID OFC	—
OFC JOINT CHAMBER	⊙
LIMITED HIEGHT SUBWAY	
LC GATE/ LX GATE	⏏
CULVERT/BRIDGE	[]
DWC & PCC	
EXISTING 6 QUAD CABLE	—

NORTH CENTRAL RAILWAY	BABA PROJECTS PVT. LTD.	
OFC ROUTE DIAGRAM FOR THE ROUTE GWALIOR TO ETAWAH	<u>DRAWN BY:-</u> Naval Kishor Singh	<u>CHECKED BY:-</u>
	ALL DIMENSION ARE IN METER (NOT TO SCALE)	

APPROVED BY RAILWAYS		
Dy. CSTE/NCRPU/ALJN	ASTE/NCRPU/ALJN	SSE/T/PU/CNB

Note: - Existing 6 Quad cable is laid towards DN side.