



NORTH CENTRAL RAILWAY

JHANSI DIVISION

AS BUILT DIAGRAM OF 24 FIBER CABLE

SUB-SECTIONS :- BHIND Stn. TO UDI MORE Stn.

DRAWN BY:-

BABA PROJECTS PVT. LTD.


2K/74, BARIATU HOUSING COLONY,

BARIATU, RANCHI-9, JHARKHAND

email :- bppl@bppl.org

STATION - BHIND (YARD AREA)

SHEET NO. 1 of 7

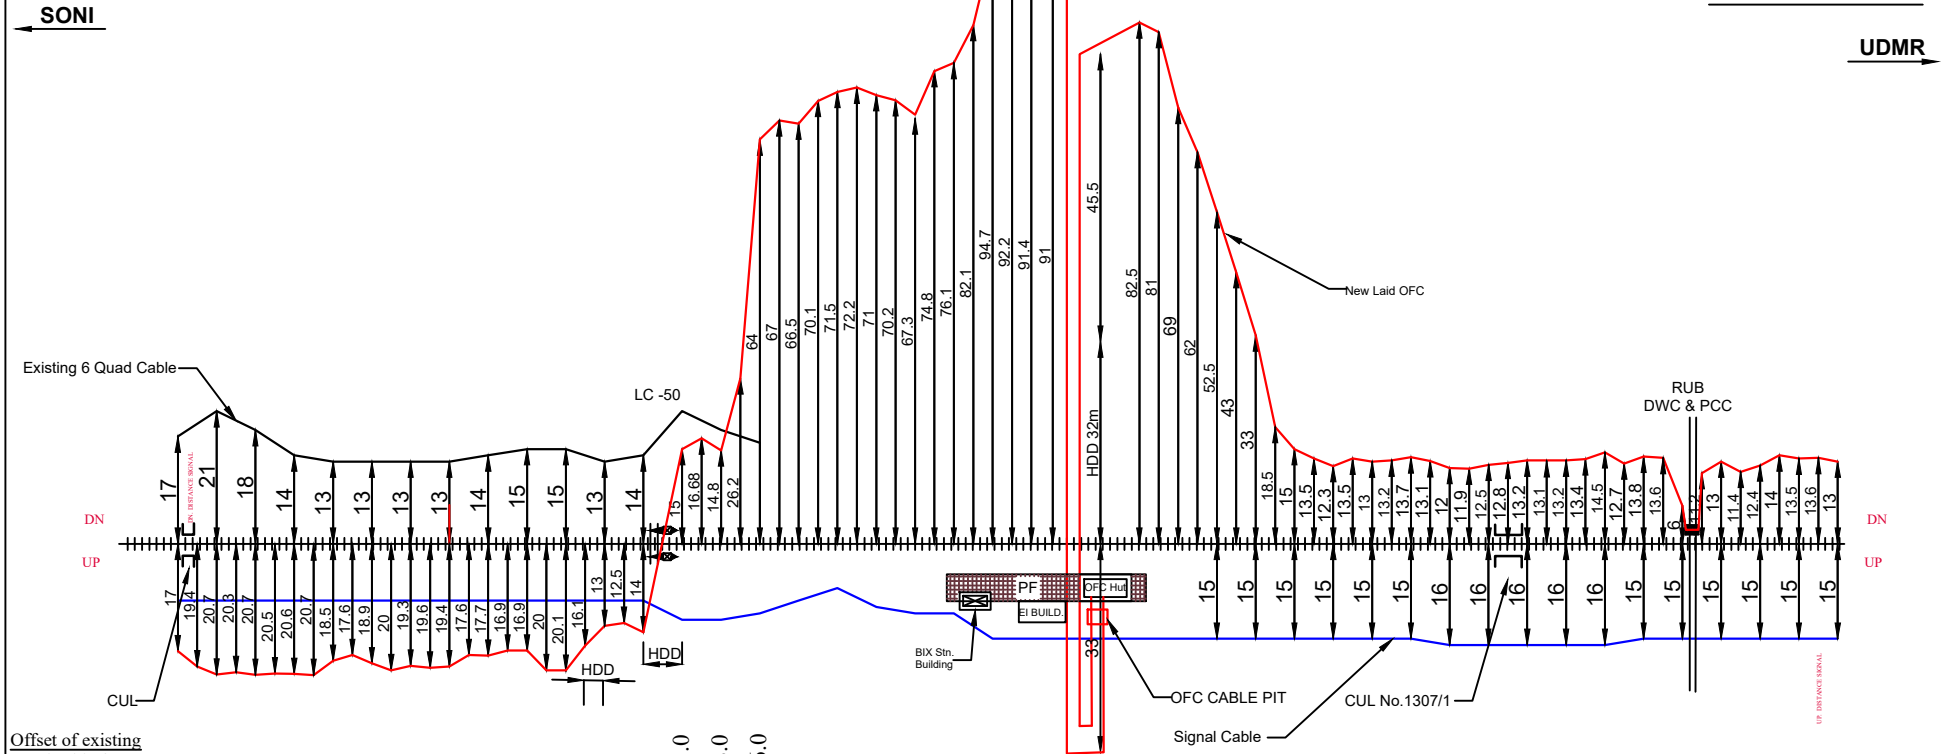

Offset of existing Quad cable from the track	
Offset of Signal cable from the track	
ROW Offset from the track	

Chainage No.

LEGENDS

OFC CABLE PIT	
DWC & PCC	
RAILWAY LINE	
NEW LAID OFC	
OFC JOINT CHAMBER	
LIMITED HEIGHT SUBWAY	
LC GATE/ LX GATE	
CULVERT/BRIDGE	
STATION BUILDING	
SIGNAL CABLE	
EXISTING 6 QUAD CABLE	

BABA PROJECTS
PVT. LTD.

DRAWN BY:-

CHECKED BY:-

ALL DIMENSION ARE IN METER
(NOT TO SCALE)

NORTH CENTRAL
RAILWAY

OFC ROUTE DIAGRAM
FOR THE ROUTE
GWALIOR TO ETAWAH

Dy. CSTE/NCRPU/ALJN


Note1: - Existing Quad cable CRP is not available after Chainage 1306/2-1306/8.
Note2: - Existing Quad cable is laid in UP side

APPROVED BY RAILWAYS

ASTE/NCRPU/ALJN

SSE/T/PU/CNB

As Built Diagram of 24F from BHIND Stn. TO UDI MORE Stn.

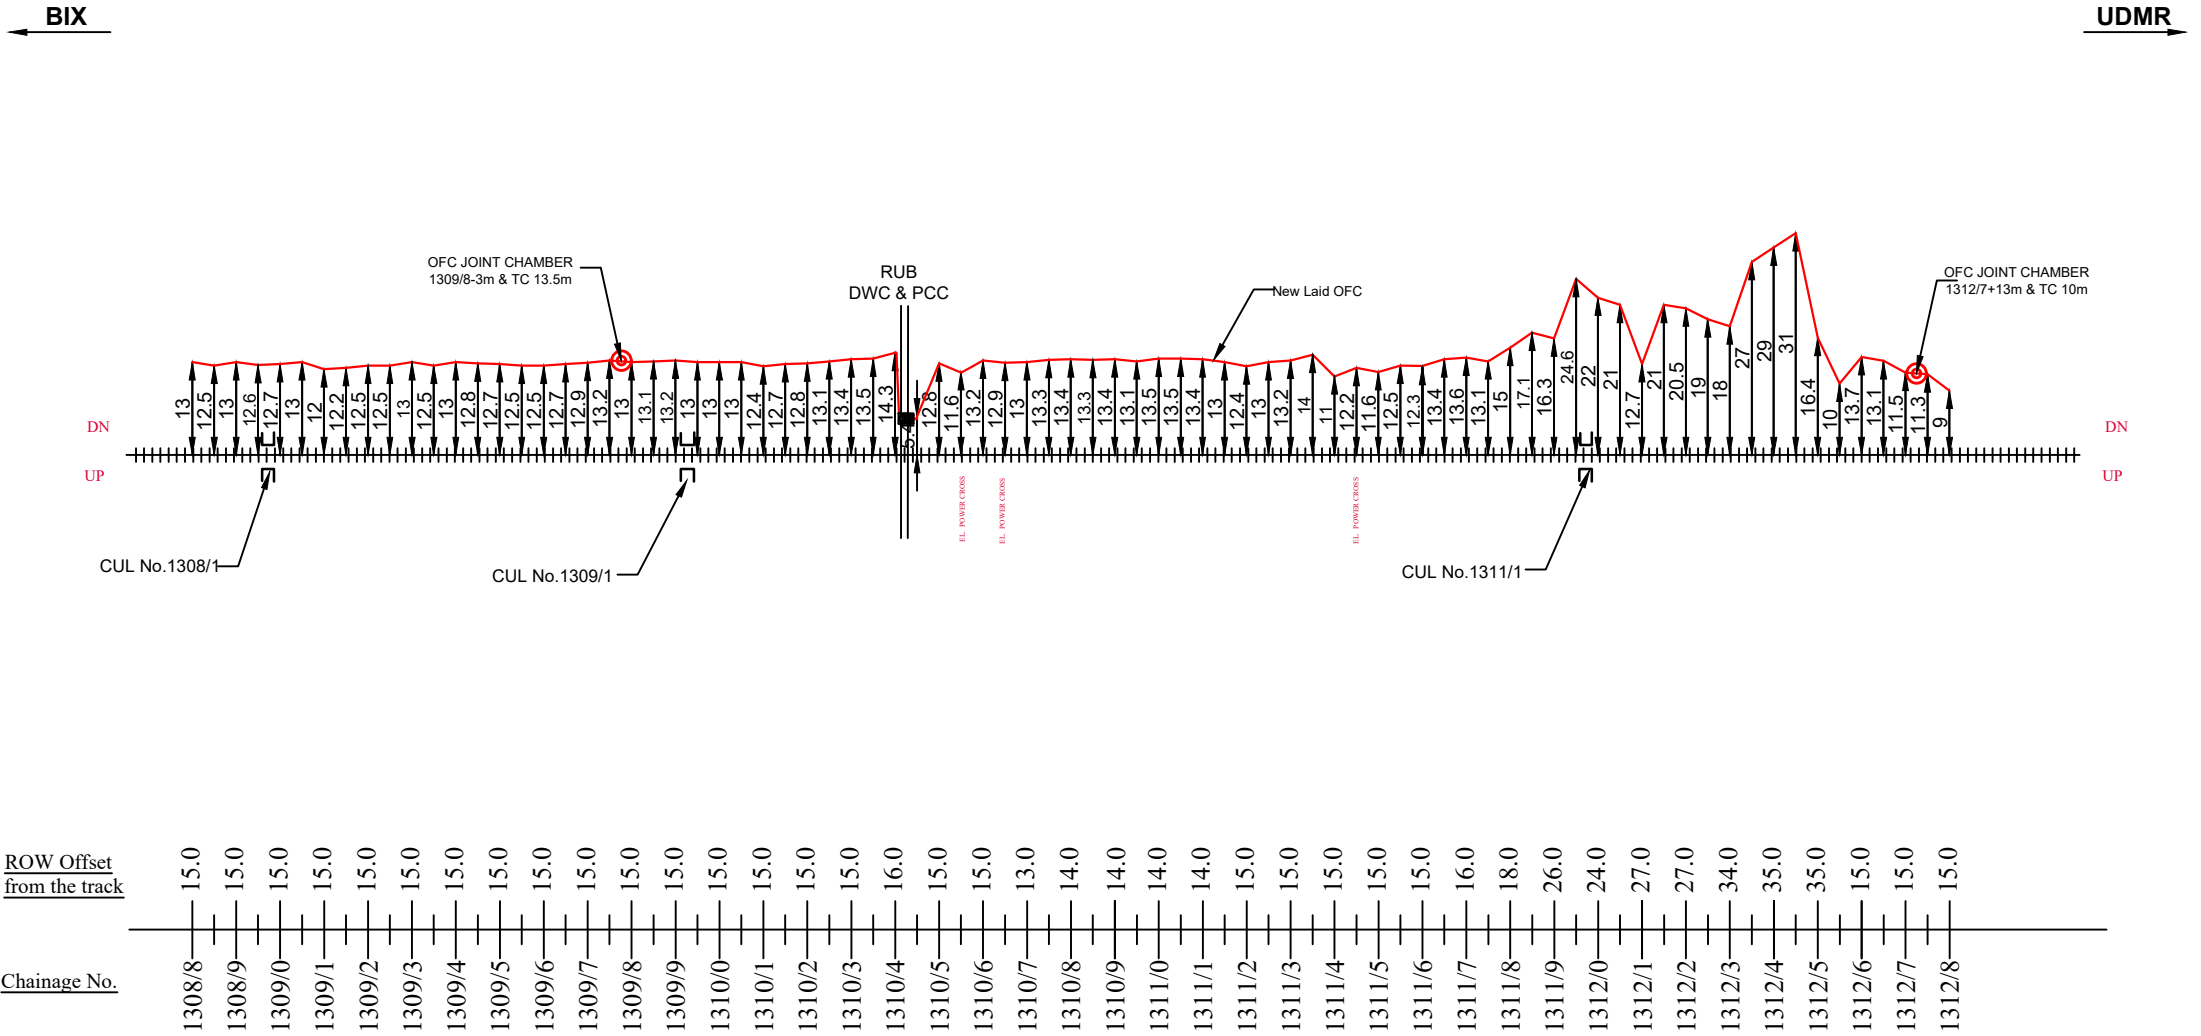

LEGENDS	
RAILWAY LINE	=====
NEW LAID OFC	—————
OFC JOINT CHAMBER	⊙
LIMITED HIEGHT SUBWAY	
LC GATE/ LX GATE	⬆ ⬆
CULVERT/BRIDGE	⌌
DWC & PCC	⌌
EXISTING 6 QUAD CABLE	—————

BABA PROJECTS PVT. LTD.		NORTH CENTRAL RAILWAY
DRAWN BY:- Naval Kishor Singh	CHECKED BY:-	
ALL DIMENSION ARE IN METER (NOT TO SCALE)		OFC ROUTE DIAGRAM FOR THE ROUTE GWALIOR TO ETAWAH

APPROVED BY RAILWAYS		
Dy. CSTE/NCRPU/ALJN	ASTE/NCRPU/ALJN	SSE/T/PU/CNB


Note: - Existing Quad cable is laid in UP Side.

As Built Diagram of 24F from BHIND Stn. TO UDI MORE Stn.

SHEET NO. 3 of 7

BIX

UDMR

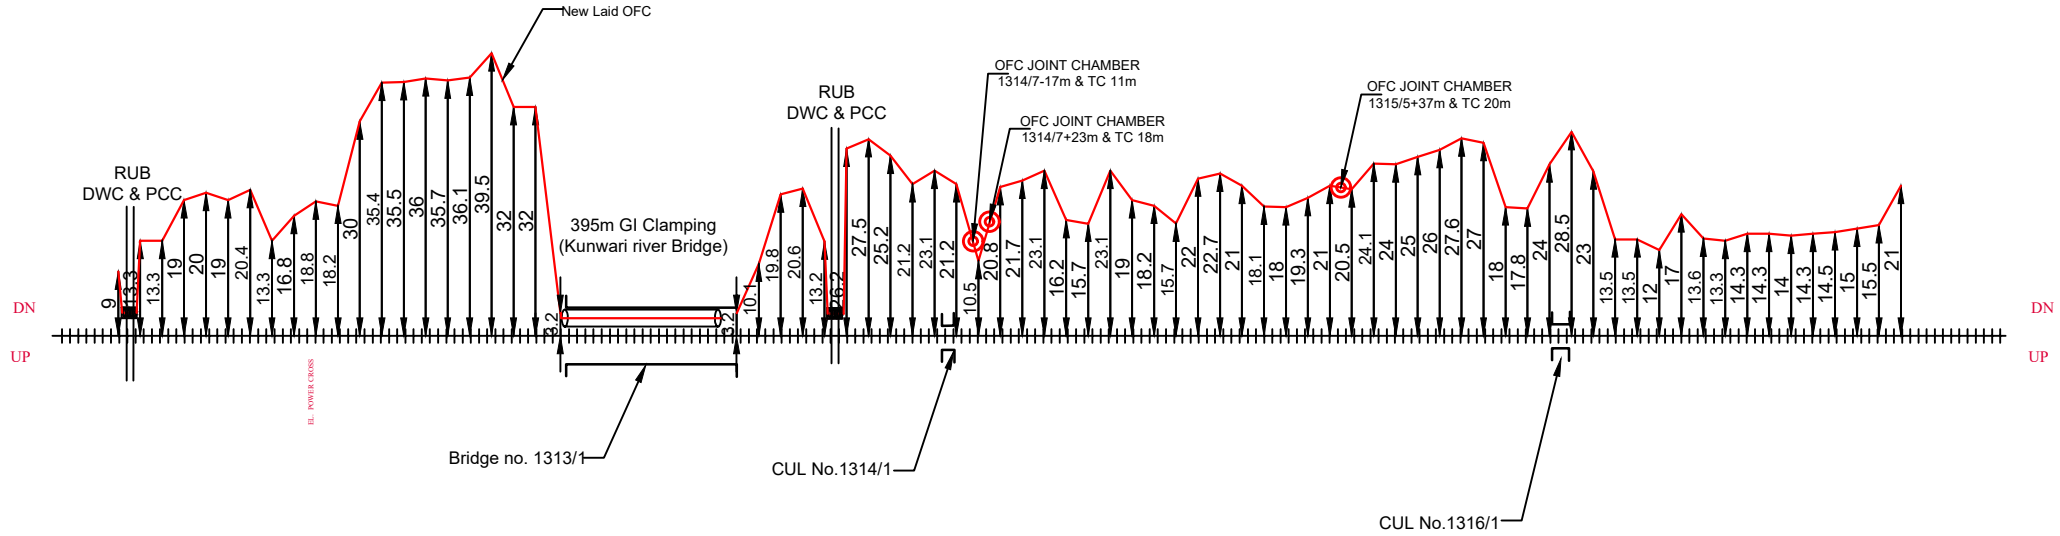

ROW Offset
from the track

Chainage No.

1312/8	15.0
1312/9	15.0
1313/0	21.0
1313/1	22.0
1313/2	20.0
1313/3	20.0
1313/4	40.0
1313/5	47.0
1313/6	50.0
1313/7	50.0
1313/7+40	50.0
1313/7+58	50.0
1313/8	50.0
1313/9	50.0
1314/0	50.0
1314/1	50.0
1314/1+40	50.0
1314/2	50.0
1314/3	47.0
1314/4	47.0
1314/5	26.0
1314/6	26.0
1314/7	27.0
1314/8	20.0
1314/9	20.0
1315/0	28.0
1315/1	27.0
1315/2	25.0
1315/3	27.0
1315/4	26.0
1315/5	26.0
1315/6	27.0
1315/7	28.0
1315/8	28.0
1315/9	28.0
1316/0	29.0
1316/1	29.0
1316/2	26.0
1316/3	26.0
1316/4	15.0
1316/5	15.0
1316/6	16.0
1316/7	16.0
1316/8	22.0

LEGENDS

GI PIPE	
RAILWAY LINE	
NEW LAID OFC	
OFC JOINT CHAMBER	
LIMITED HIEGHT SUBWAY	
LC GATE/ LX GATE	
CULVERT/BRIDGE	
DWC & PCC	
EXISTING 6 QUAD CABLE	


BABA PROJECTS PVT. LTD.	
DRAWN BY:-	CHECKED BY:-
Naval Kishor Singh	
ALL DIMENSION ARE IN METER (NOT TO SCALE)	

NORTH CENTRAL RAILWAY
OFC ROUTE DIAGRAM FOR THE ROUTE GWALIOR TO ETAWAH

APPROVED BY RAILWAYS		
Dy. CSTE/NCRPU/ALJN	ASTE/NCRPU/ALJN	SSE/T/PU/CNB

Note: - Existing Quad cable is laid in UP Side.

As Built Diagram of 24F from BHIND Stn. TO UDI MORE Stn.

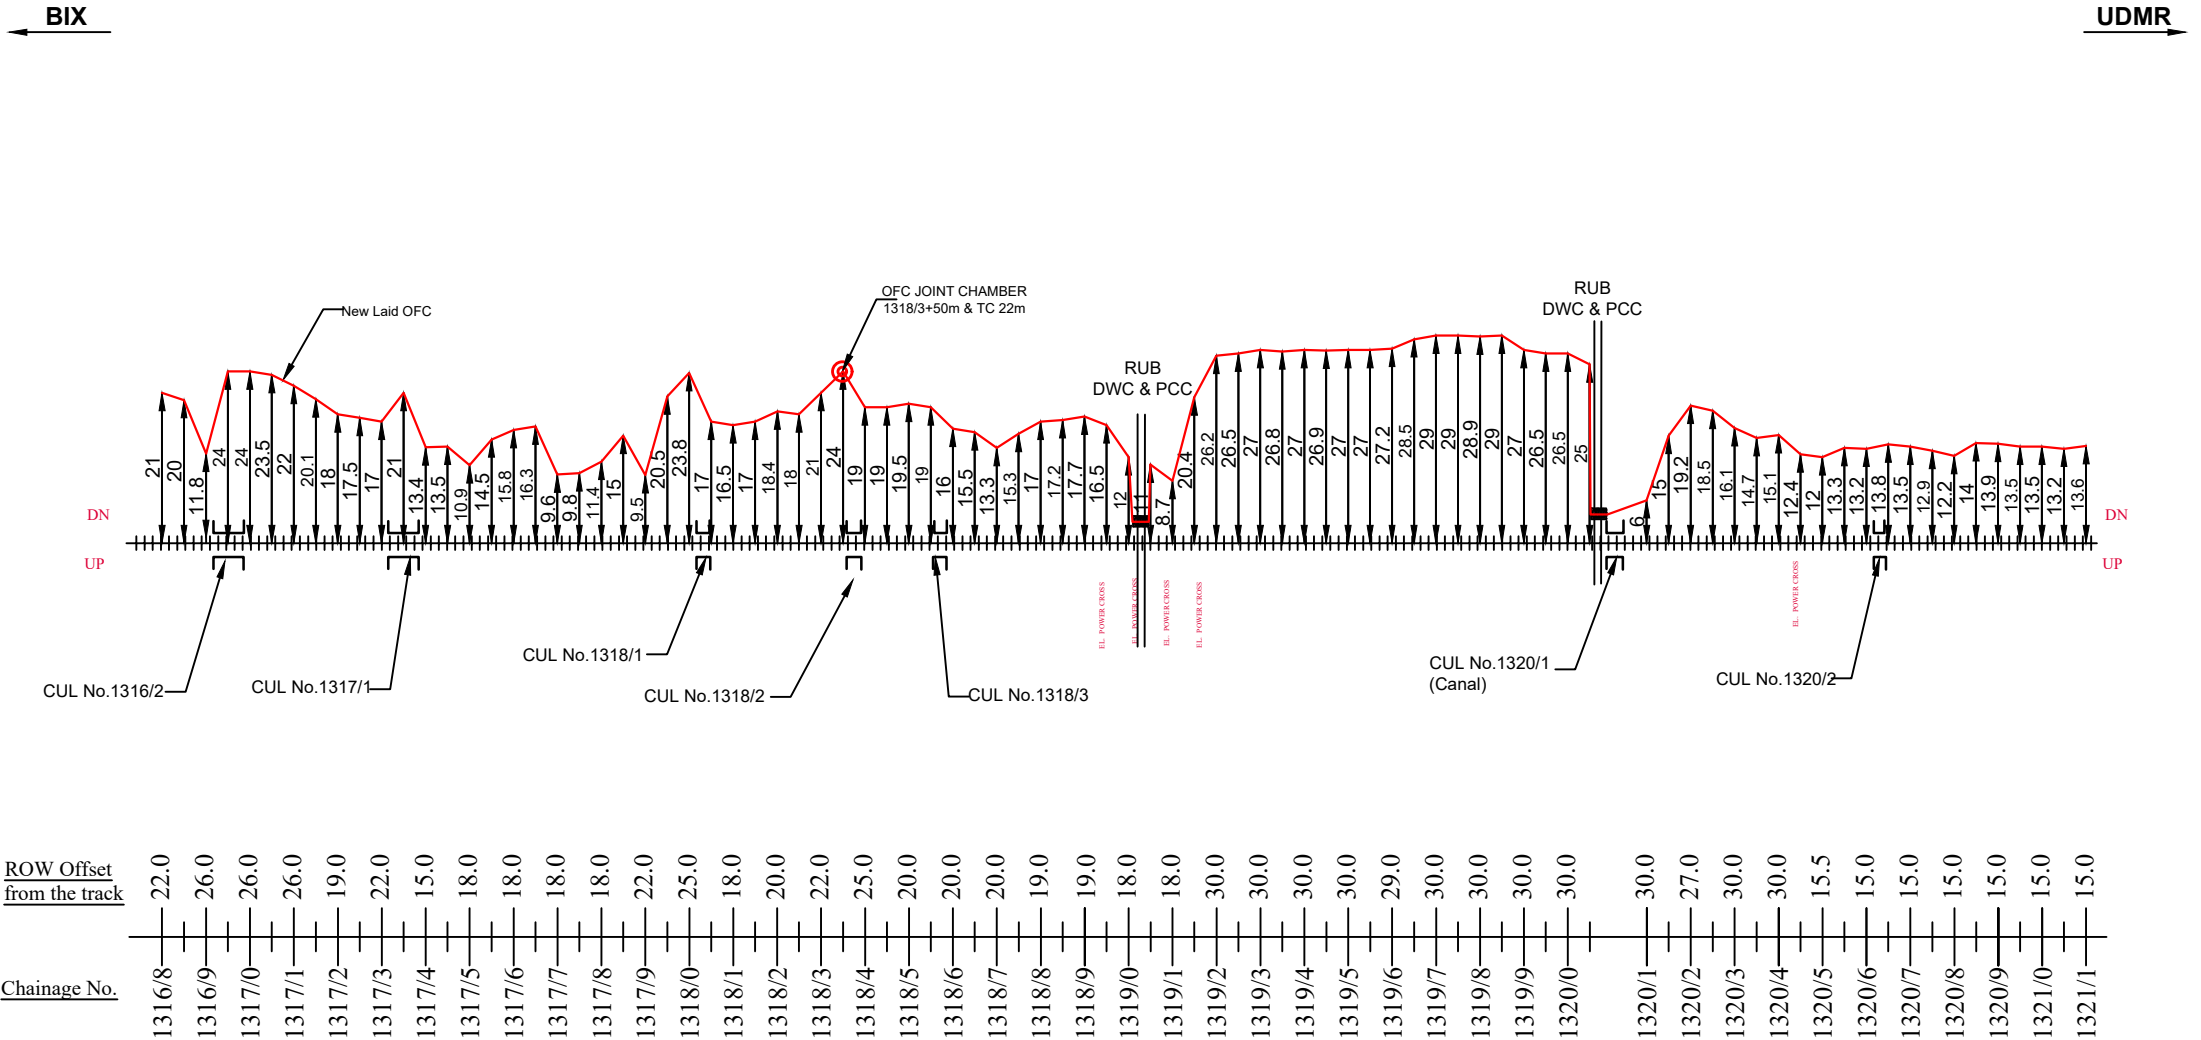

LEGENDS

RAILWAY LINE	=====
NEW LAID OFC	-----
OFC JOINT CHAMBER	⊙
LIMITED HIEGHT SUBWAY	
LC GATE/ LX GATE	⌈ ⌋
CULVERT/BRIDGE	⌈ ⌋
DWC & PCC	⌈ ⌋
EXISTING 6 QUAD CABLE	-----


BABA PROJECTS PVT. LTD.	
DRAWN BY:-	CHECKED BY:-
Naval Kishor Singh	
ALL DIMENSION ARE IN METER (NOT TO SCALE)	

NORTH CENTRAL RAILWAY
OFC ROUTE DIAGRAM FOR THE ROUTE GWALIOR TO ETAWAH

APPROVED BY RAILWAYS		
Dy. CSTE/NCRPU/ALJN	ASTE/NCRPU/ALJN	SSE/T/PU/CNB

Note: - Existing Quad cable is laid in UP Side.

As Built Diagram of 24F from BHIND Stn. TO UDI MORE Stn.

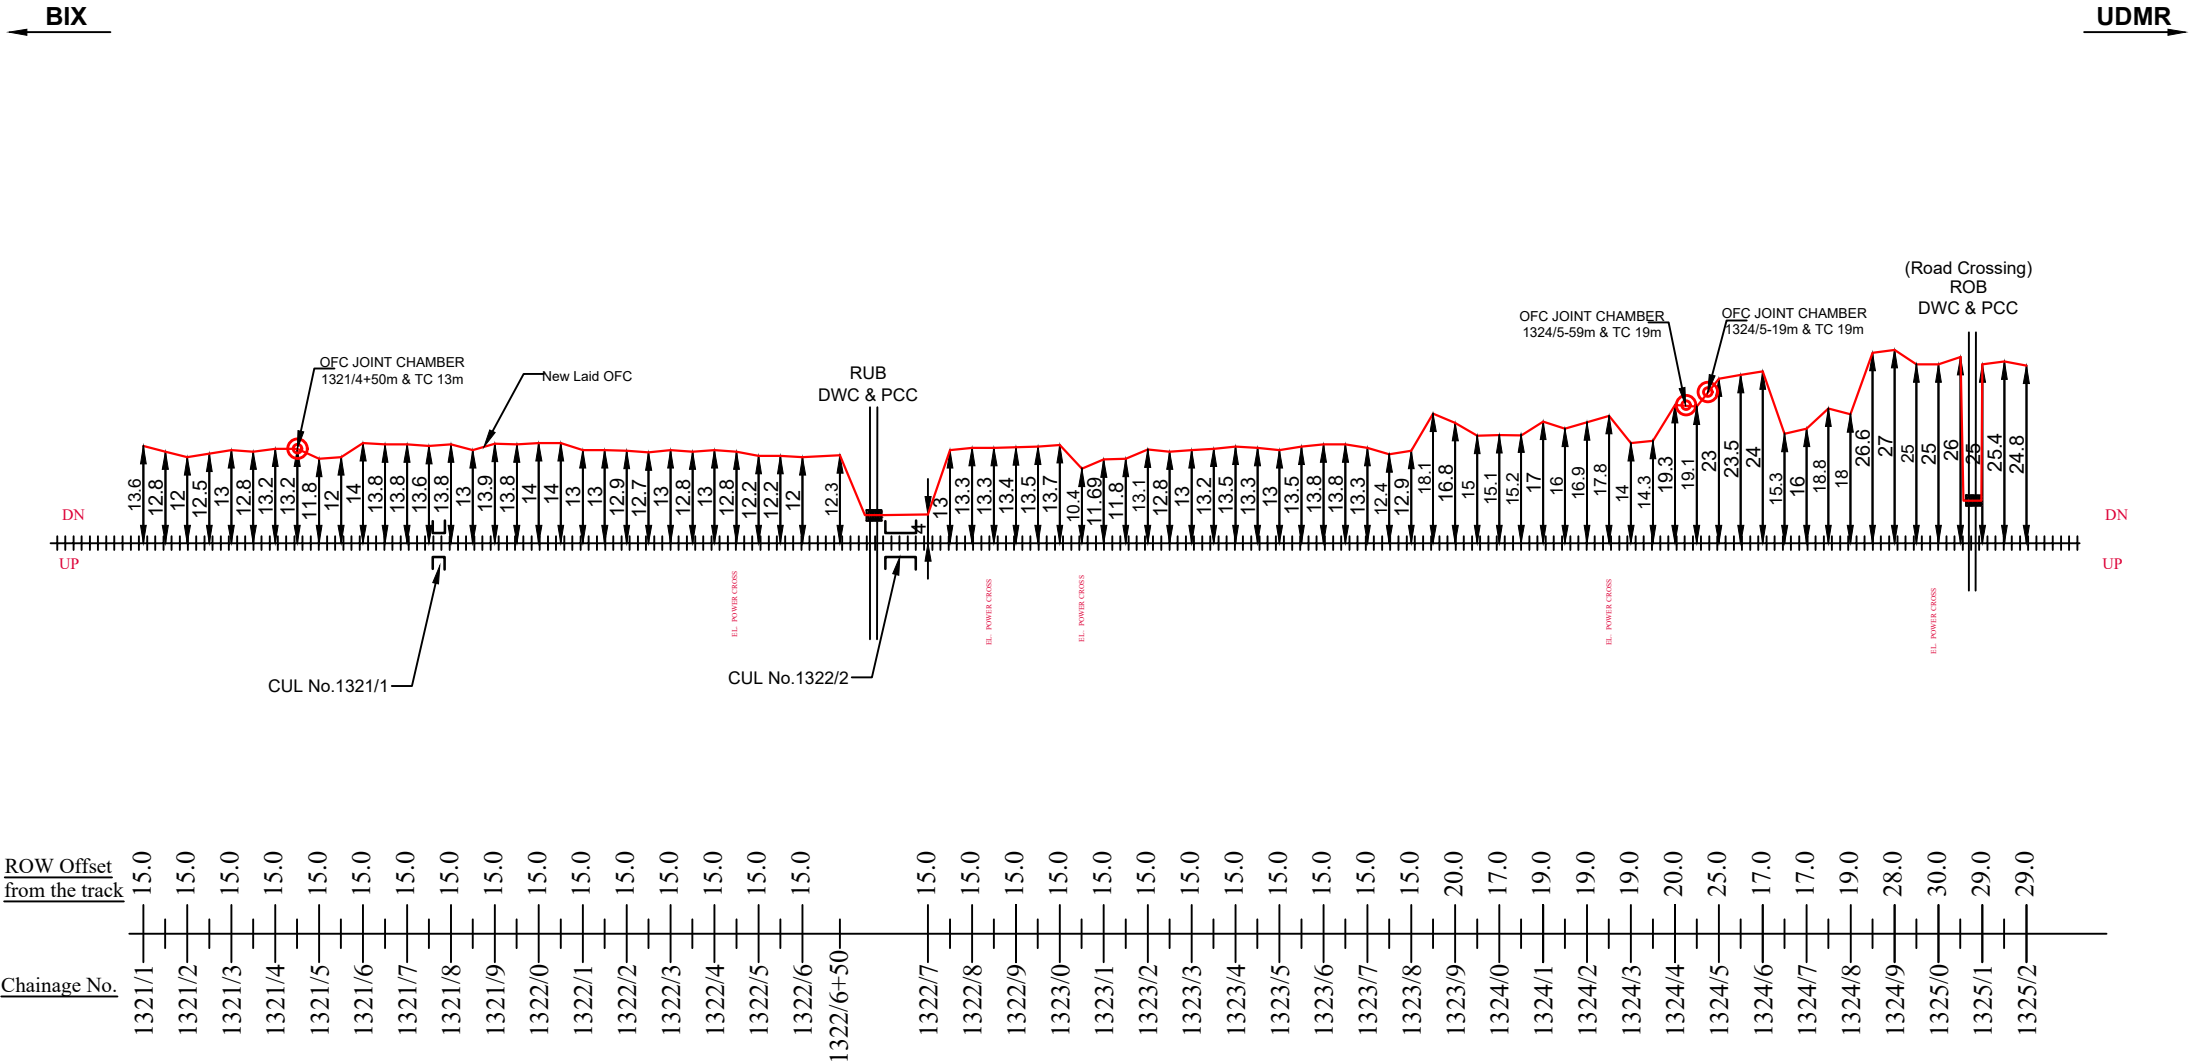

LEGENDS

RAILWAY LINE	=====
NEW LAID OFC	=====
OFC JOINT CHAMBER	⊙
LIMITED HIEGHT SUBWAY	
LC GATE/ LX GATE	⏏
CULVERT/BRIDGE	[]
DWC & PCC	[]
EXISTING 6 QUAD CABLE	=====

BABA PROJECTS PVT. LTD.	
DRAWN BY:-	CHECKED BY:-
Naval Kishor Singh	
ALL DIMENSION ARE IN METER (NOT TO SCALE)	

NORTH CENTRAL RAILWAY
OFC ROUTE DIAGRAM FOR THE ROUTE GWALIOR TO ETAWAH

APPROVED BY RAILWAYS		
Dy. CSTE/NCRPU/ALJN	ASTE/NCRPU/ALJN	SSE/T/PU/CNB


Note: - Existing Quad cable is laid in UP Side.

As Built Diagram of 24F from BHIND Stn. TO UDI MORE Stn.

SHEET NO. 6 of 7

BIX

UDMR

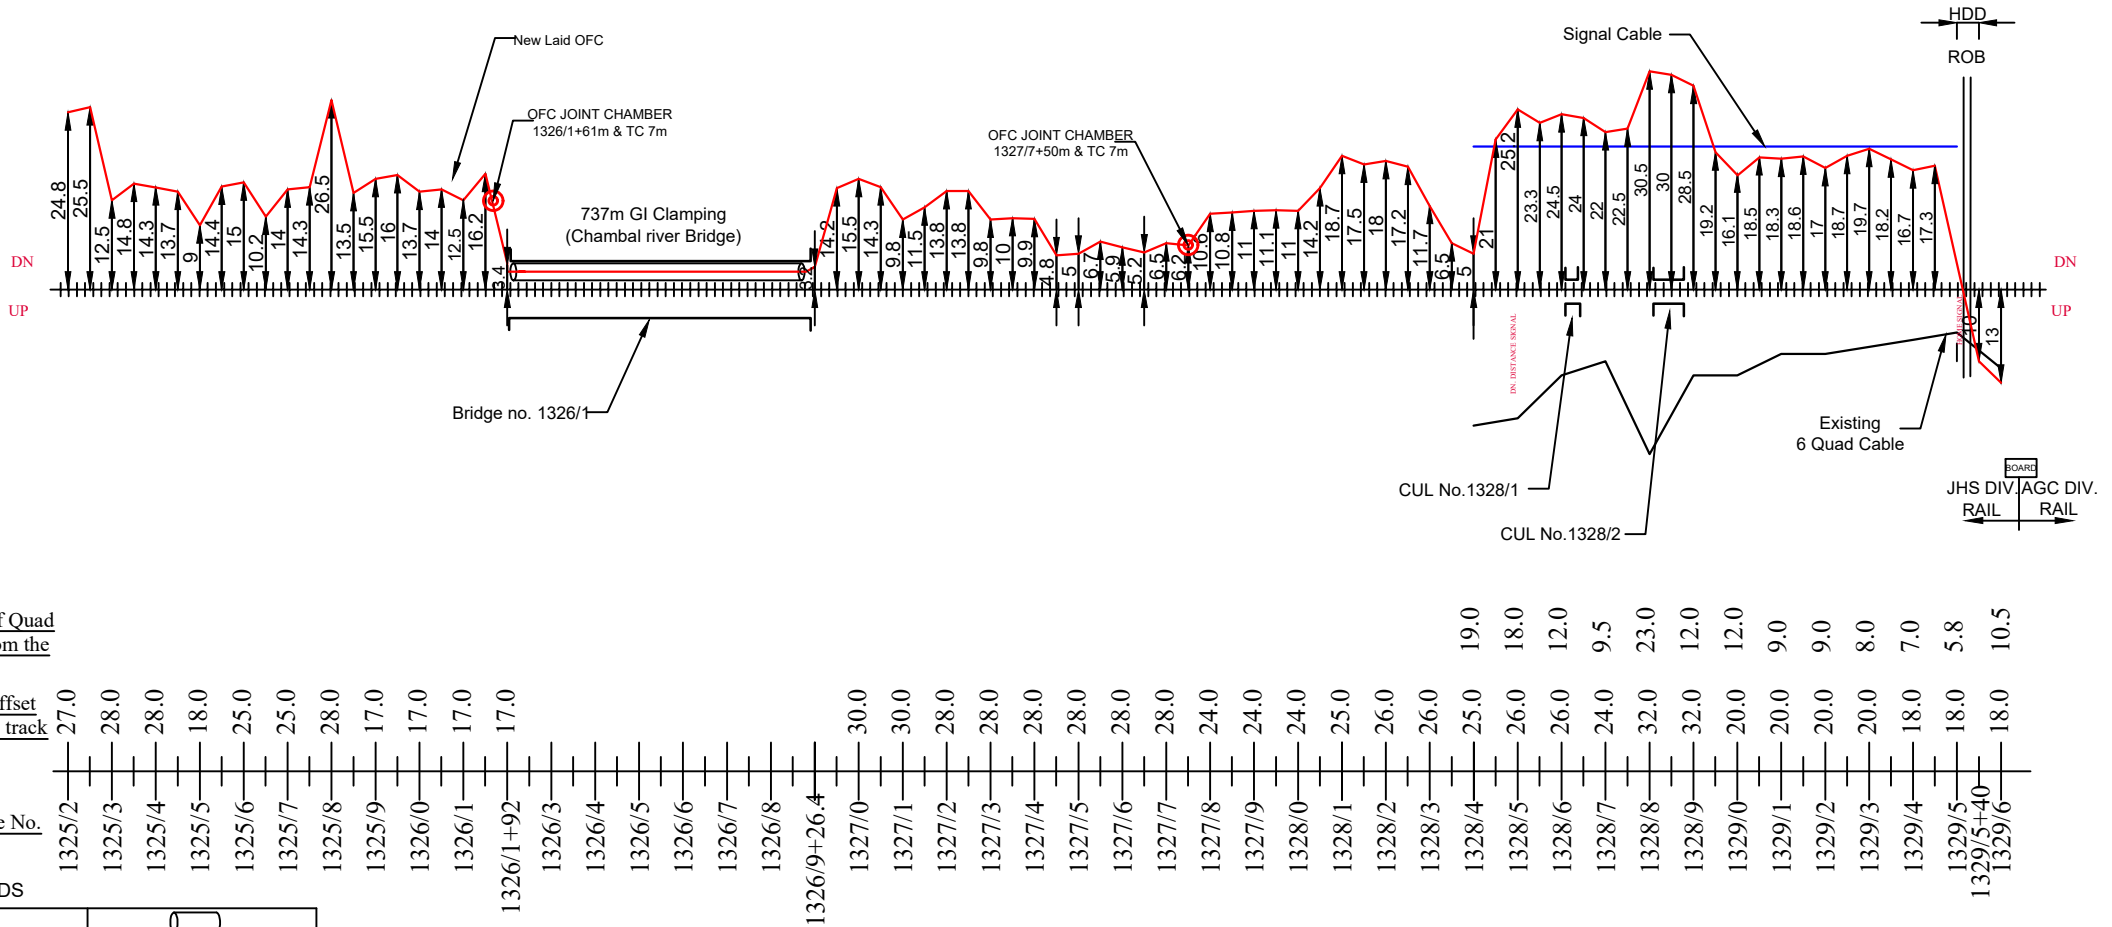

Offset of Quad cable from the track

ROW Offset from the track

Chainage No.

LEGENDS

GI PIPE	
RAILWAY LINE	
NEW LAID OFC	
OFC JOINT CHAMBER	
LIMITED HEIGHT SUBWAY	
LC GATE/ LX GATE	
CULVERT/BRIDGE	
DWC & PCC	
SIGNAL CABLE	
EXISTING 6 QUAD CABLE	

BABA PROJECTS PVT. LTD.	
DRAWN BY:-	CHECKED BY:-
Naval Kishor Singh	
ALL DIMENSION ARE IN METER (NOT TO SCALE)	

NORTH CENTRAL RAILWAY
OFC ROUTE DIAGRAM FOR THE ROUTE GWALIOR TO ETAWAH

APPROVED BY RAILWAYS		
Dy. CSTE/NCRPU/ALJN	ASTE/NCRPU/ALJN	SSE/T/PU/CNB

Note: - Existing Quad cable is laid in UP Side.


As Built Diagram of 24F from BHIND Stn. TO UDI MORE Stn.

SHEET NO. 7 of 7

BIX

ETW

STATION - UDI MORE (YARD AREA)

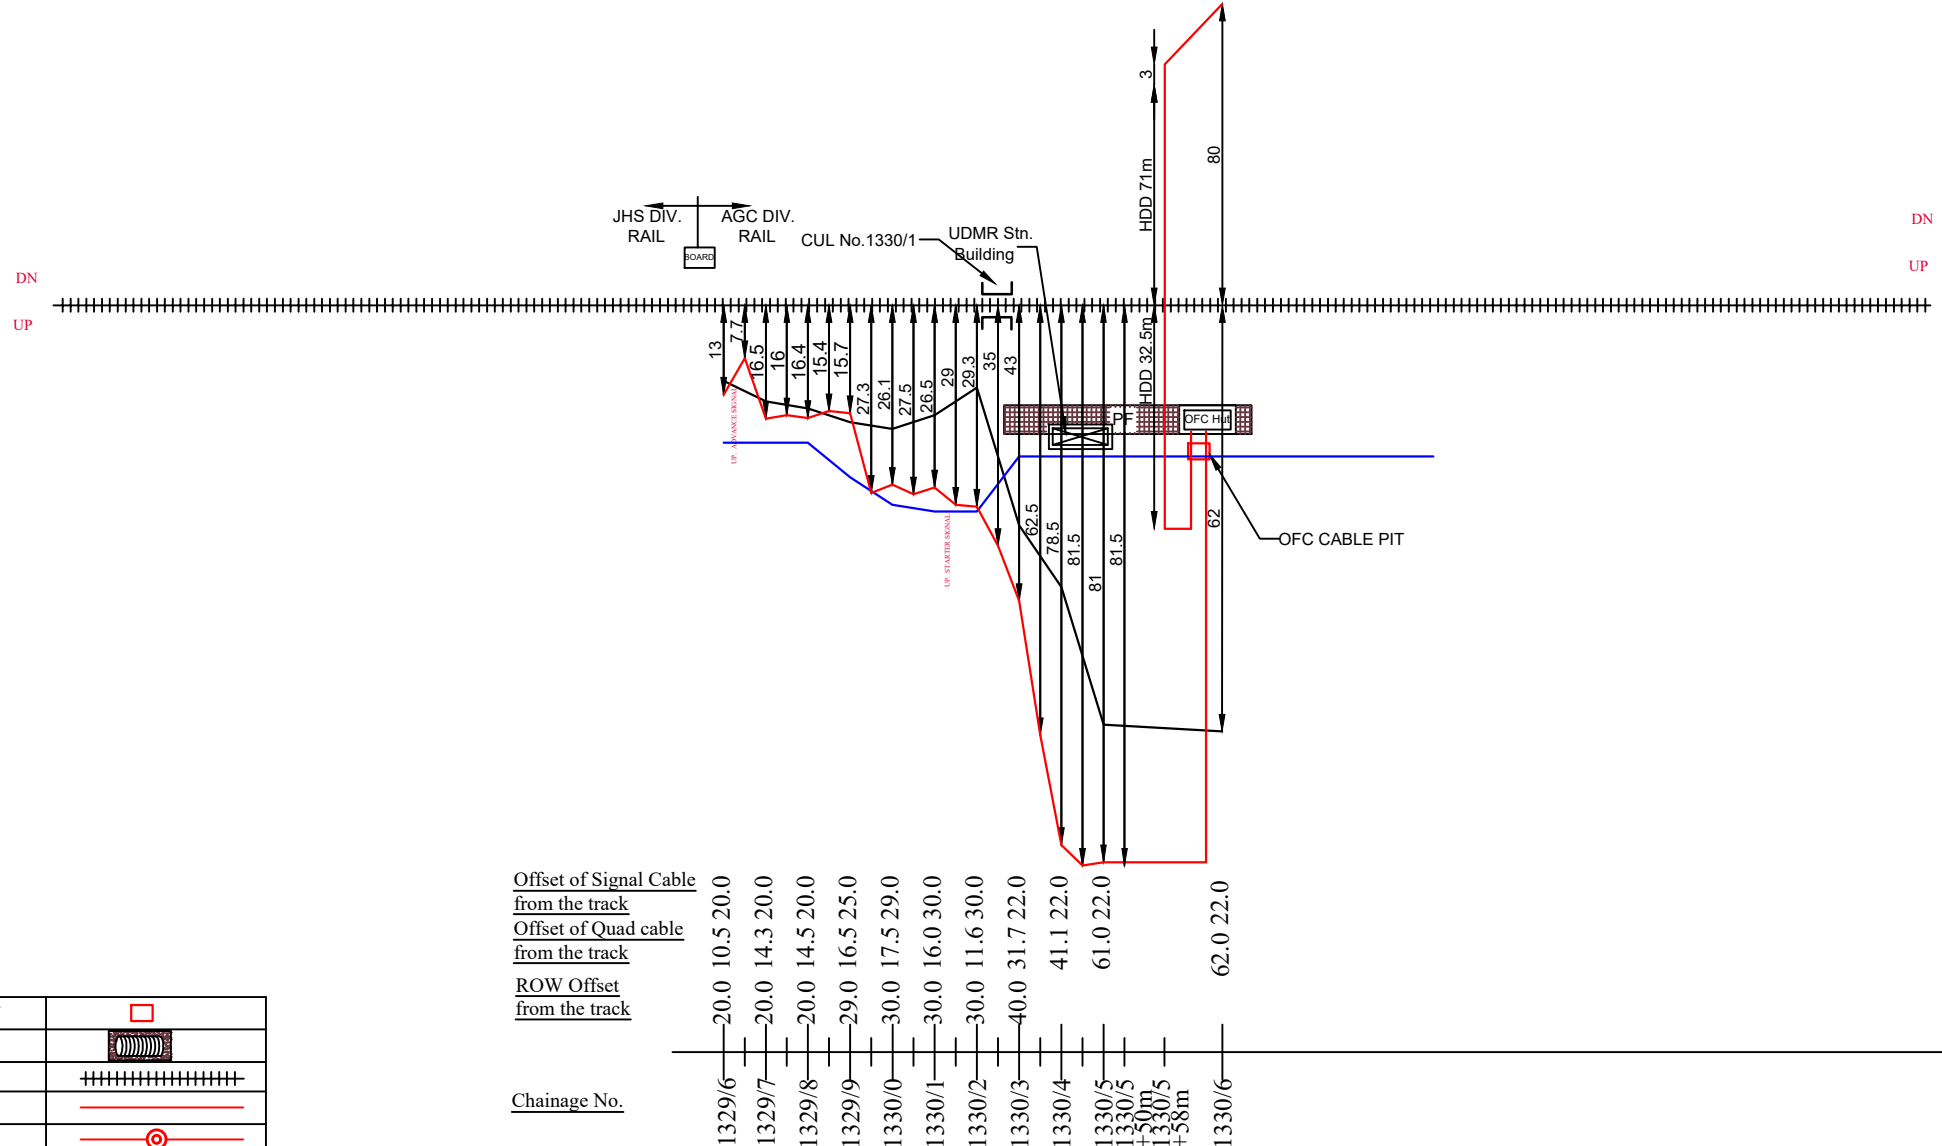

LEGENDS

OFC CABLE PIT	
DWC & PCC	
RAILWAY LINE	
NEW LAID OFC	
OFC JOINT CHAMBER	
LIMITED HIEGHT SUBWAY	
LC GATE/ LX GATE	
CULVERT/BRIDGE	
STATION BUILDING	
SIGNAL CABLE	
EXISTING 6 QUAD CABLE	

BABA PROJECTS
PVT. LTD.

NORTH CENTRAL
RAILWAY

APPROVED BY RAILWAYS

DRAWN BY:-

CHECKED BY:-

Naval Kishor Singh

OFC ROUTE DIAGRAM
FOR THE ROUTE
GWALIOR TO ETAWAH

ALL DIMENSION ARE IN METER
(NOT TO SCALE)

Dy. CSTE/NCRPU/ALJN

ASTE/NCRPU/ALJN

SSE/T/PU/CNB