

NORTH CENTRAL RAILWAY

PRAYAGRAJ DIVISION

AS BUILT DIAGRAM OF 24 FIBER CABLE

SUB-SECTION :- AHIRAURA ROAD Stn. to KAYLIHUT Stn. (686/08 TO 694/26)

CONTRACTOR

TCIL

TCIL BHAWAN, GREATER KAILASH BHAWAN-1


NEW DELHI - 110048

Dy. CSTE/P-III/PRYJ

ASTE/P/HQ/PRYJ

SSE/T/NCRPU/PRYJ

As built diagram of 24F laid between AHIRAURA ROAD Stn. to KAYLIHUT Stn.

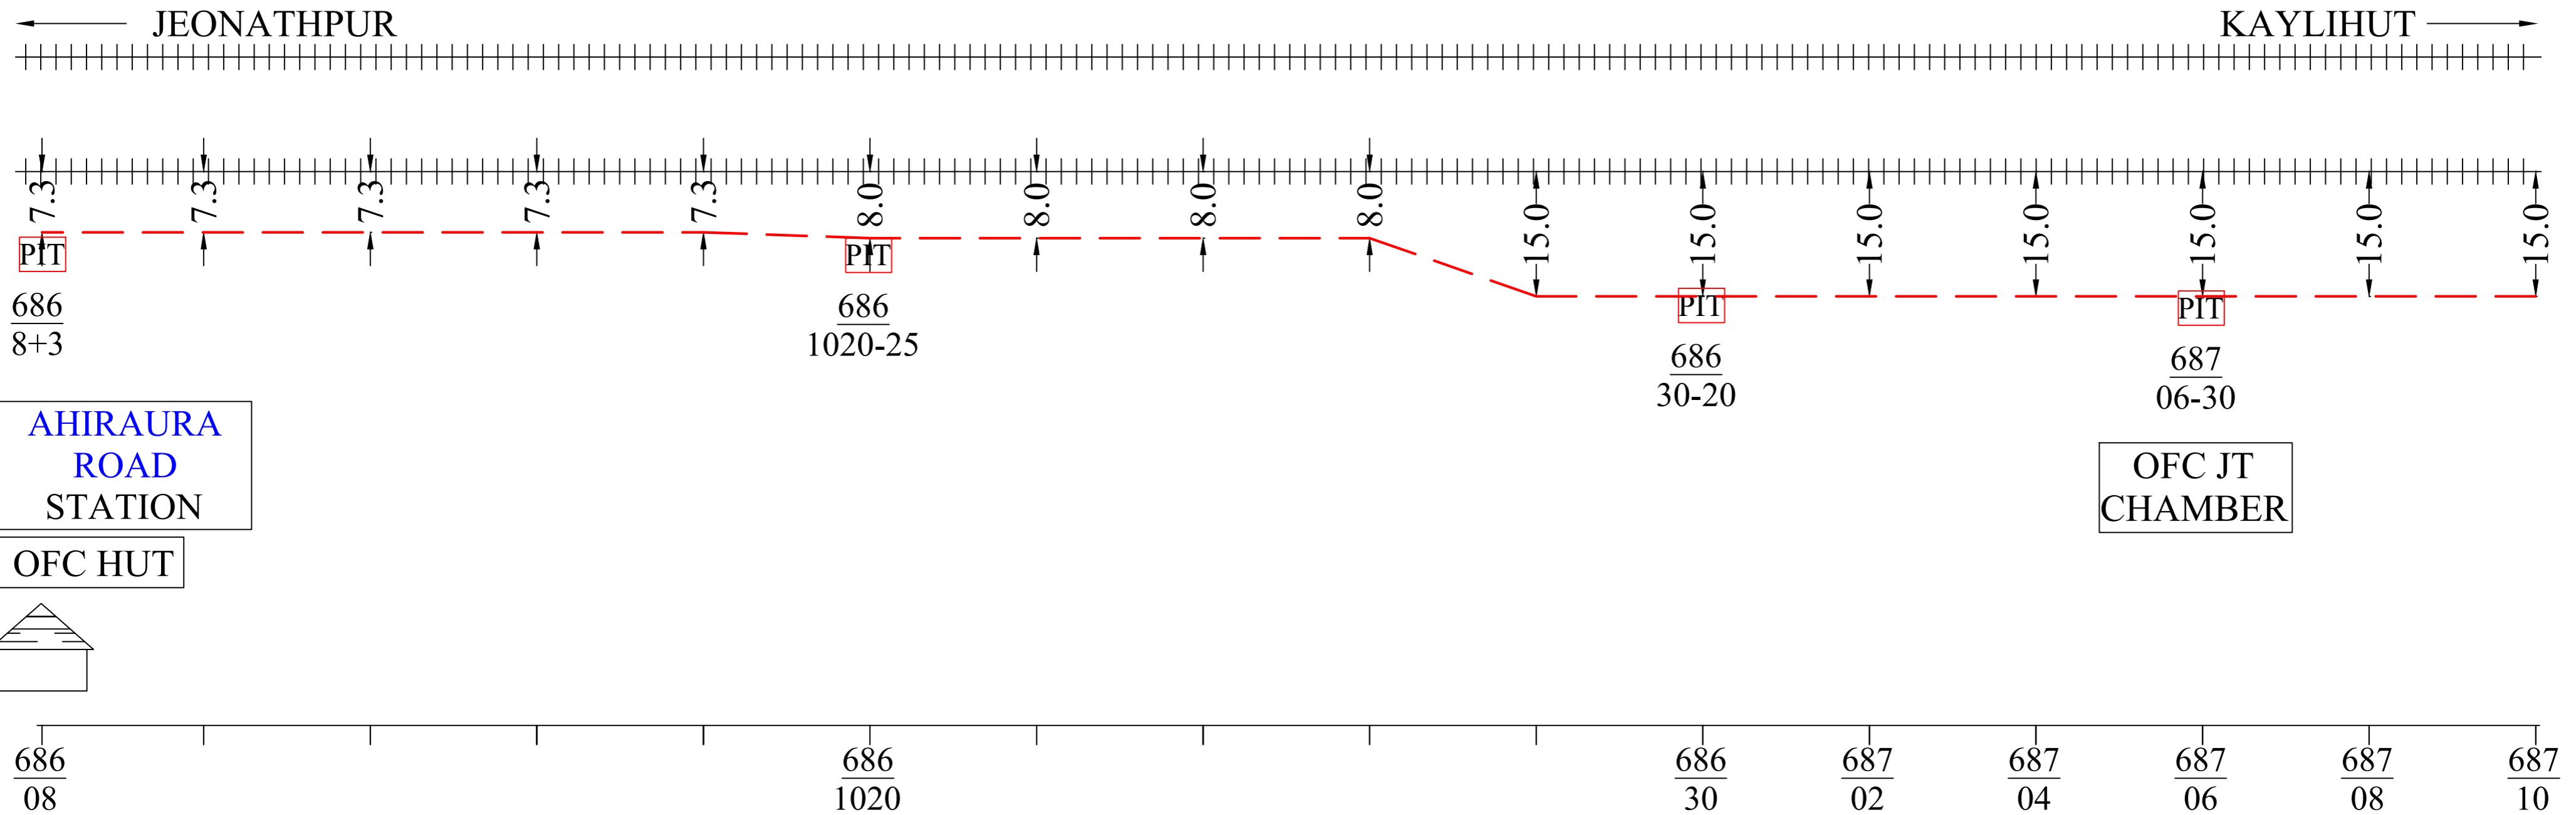

LEGENDS

RAILWAY LINE	+++++
NEW LAID OFC	-----
OFC JOINT	-----○-----
LIMITED HEIGHT SUBWAY	
LC GATE/ LX GATE	x x
CULVERT/BRIDGE	-----
STATION	⊙
GI PIPE	⌈⌋
DWC	⌈⌋⌈⌋⌈⌋
RAILWAY BOUNDRY	-----
EXISTING 6 QUAD CABLE	-----

Note: - Laying of OFC as per RDSO L.NO.CBS/DCP/1, Dated 30.10.2009 & chief signal & Telecom Engineer/ALD L No. S&T/NCR/JPO(1/S&T/2012) Dated June 4, 2012)

APPROVED BY RAILWAYS

NORTH CENTRAL RAILWAY

RST INFOCOM PVT. LTD.

AS BUILT DIAGRAM OF 24F FOR THE ROUTE AHIRAURA Stn. TO KAYLIHUT Stn.

DRAWN BY:-
NAND KISHORE
Mob- +91 8960287304

CHECKED BY:-

ALL DIMENSION ARE IN METER (NOT TO SCALE)


TCIL/NEW DELHI

RCIL/PRYJ

SSE/T/PRYJ DIVISION

SSE/TELE/NCRPU/PRYJ

As built diagram of 24F laid between AHIRAURA ROAD Stn. to KAYLIHUT Stn.

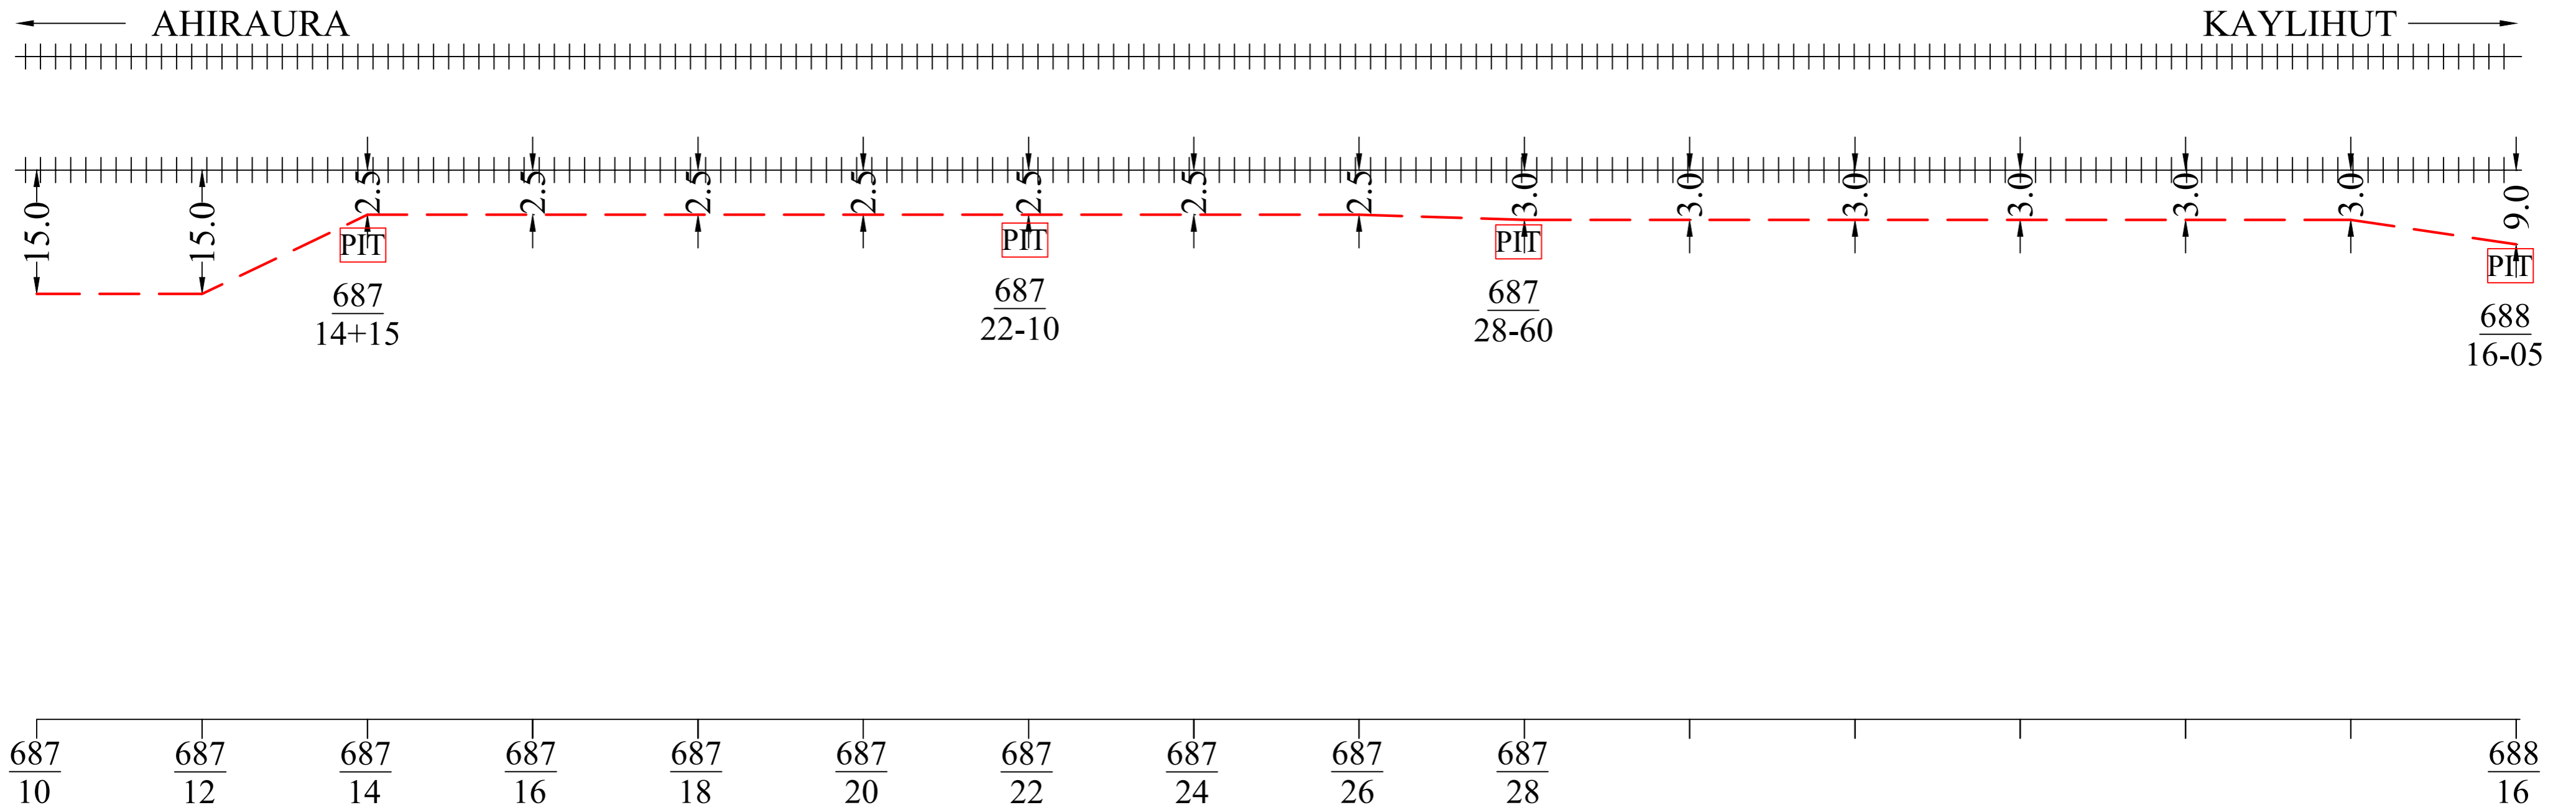

Note: - Laying of OFC as per RDSO L.NO.CBS/DCP/1, Dated 30.10.2009 & chief signal & Telecom Engineer/ALD L No. S&T/NCR/JPO(1/S&T/2012) Dated June 4, 2012)

APPROVED BY RAILWAYS

NORTH CENTRAL RAILWAY

RST INFOCOM PVT. LTD.

AS BUILT DIAGRAM OF 24F FOR THE ROUTE AHIRAURA Stn. TO KAYLIHUT Stn.

DRAWN BY:-
NAND KISHORE
Mob- +91 8960287304

CHECKED BY:-

ALL DIMENSION ARE IN METER (NOT TO SCALE)

LEGENDS

RAILWAY LINE	+++++
NEW LAID OFC	— — — — —
OFC JOINT	— — — — —
LIMITED HIEGHT SUBWAY	
LC GATE/ LX GATE	
CULVERT/BRIDGE	[]
STATION	⊙
GI PIPE	⊂
DWC	⊂
RAILWAY BOUNDRY	— — — — —
EXISTING 6 QUAD CABLE	— — — — —


TCIL/NEW DELHI

RCIL/PRYJ

SSE/T/PRYJ DIVISION

SSE/TELE/NCRPU/PRYJ

As built diagram of 24F laid between AHIRAURA ROAD Stn. to KAYLIHUT Stn.

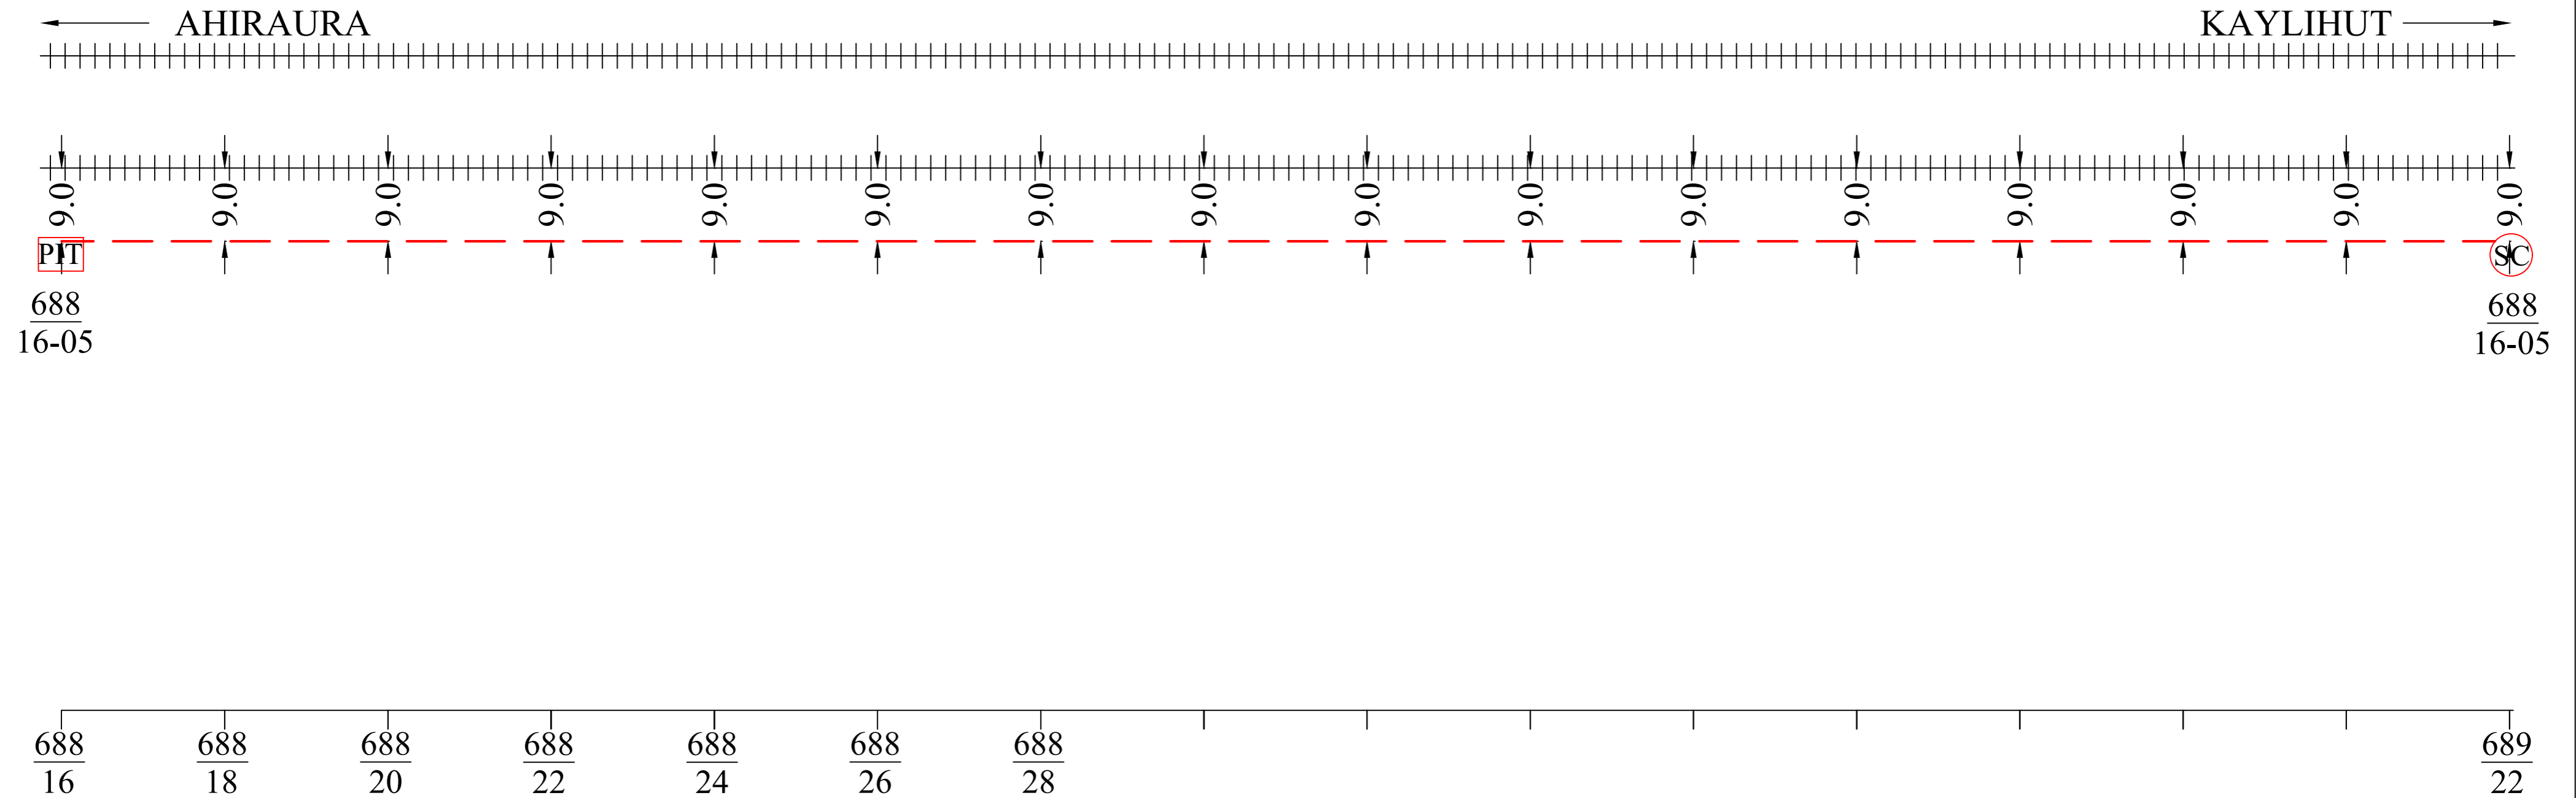

Note: - Laying of OFC as per RDSO L.NO.CBS/DCP/1, Dated 30.10.2009 & chief signal & Telecom Engineer/ALD L No. S&T/NCR/JPO(1/S&T/2012) Dated June 4, 2012)

APPROVED BY RAILWAYS

NORTH CENTRAL RAILWAY

RST INFOCOM PVT. LTD.

AS BUILT DIAGRAM OF 24F FOR THE ROUTE AHIRAURA Stn. TO KAYLIHUT Stn.

DRAWN BY:-
NAND KISHORE
Mob- +91 8960287304

CHECKED BY:-

ALL DIMENSION ARE IN METER (NOT TO SCALE)

LEGENDS

RAILWAY LINE	+++++
NEW LAID OFC	— — — — —
OFC JOINT	— — — — — ⊙ — — — — —
LIMITED HIEGHT SUBWAY	
LC GATE/ LX GATE	x x
CULVERT/BRIDGE	[— — — —]
STATION	⊙
GI PIPE	⊂
DWC	⊂⊂⊂⊂⊂
RAILWAY BOUNDRY	- - - - -
EXISTING 6 QUAD CABLE	— — — — —


TCIL/NEW DELHI

RCIL/PRYJ

SSE/T/PRYJ DIVISION

SSE/TELE/NCRPU/PRYJ

As built diagram of 24F laid between AHIRAURA ROAD Stn. to KAYLIHUT Stn.

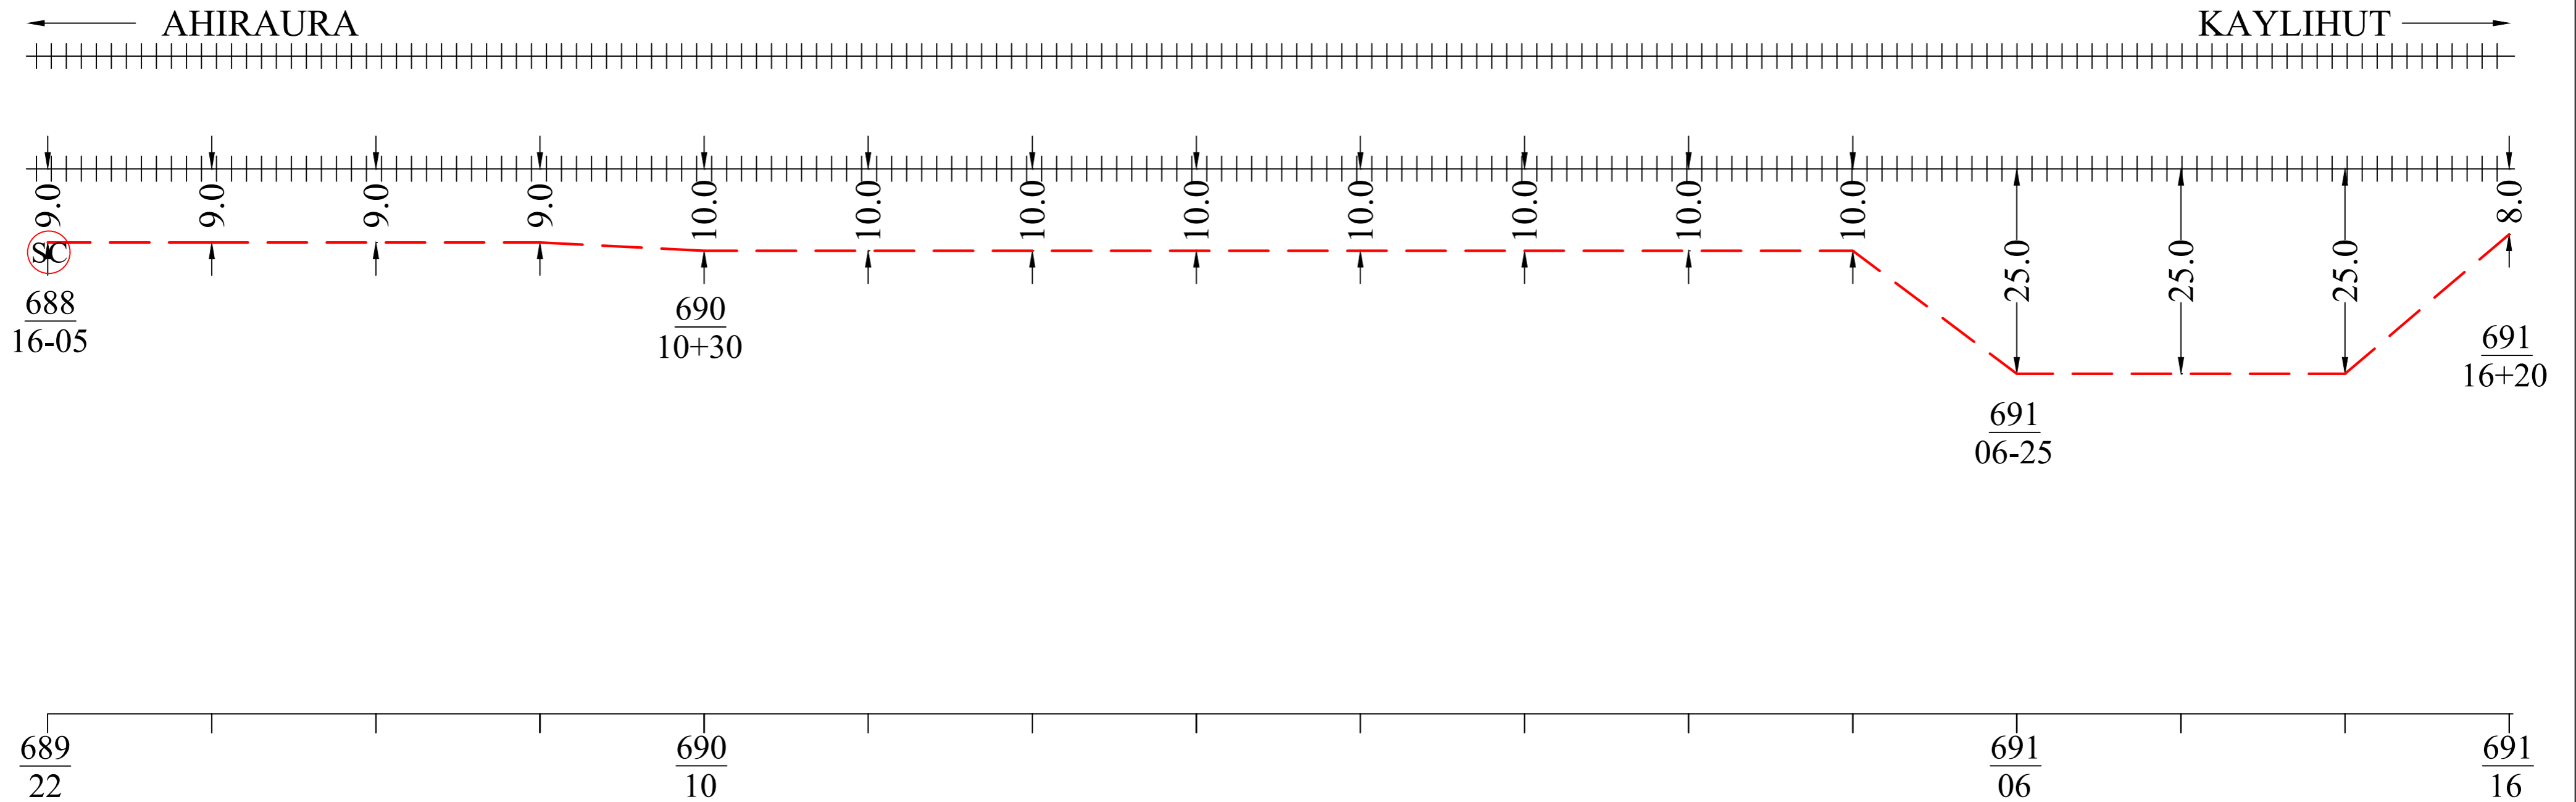

Note: - Laying of OFC as per RDSO L.NO.CBS/DCP/1, Dated 30.10.2009 & chief signal & Telecom Engineer/ALD L No. S&T/NCR/JPO(1/S&T/2012) Dated June 4, 2012)


APPROVED BY RAILWAYS			
TCIL/NEW DELHI	RCIL/PRYJ	SSE/T/PRYJ DIVISION	SSE/TELE/NCRPU/PRYJ

NORTH CENTRAL RAILWAY
AS BUILT DIAGRAM OF 24F FOR THE ROUTE AHIRAURA Stn. TO KAYLIHUT Stn.

RST INFOCOM PVT. LTD.	
DRAWN BY:- NAND KISHORE Mob- +91 8960287304	CHECKED BY:-
ALL DIMENSION ARE IN METER (NOT TO SCALE)	

LEGENDS	
RAILWAY LINE	+++++
NEW LAID OFC	-----
OFC JOINT	⊙
LIMITED HIEGHT SUBWAY	
LC GATE/ LX GATE	x
CULVERT/BRIDGE	[]
STATION	Ⓜ
GI PIPE	⌈ ⌋
DWC	⌈ ⌋
RAILWAY BOUNDRY	-----
EXISTING 6 QUAD CABLE	-----

As built diagram of 24F laid between AHIRAURA ROAD Stn. to KAYLIHUT Stn.

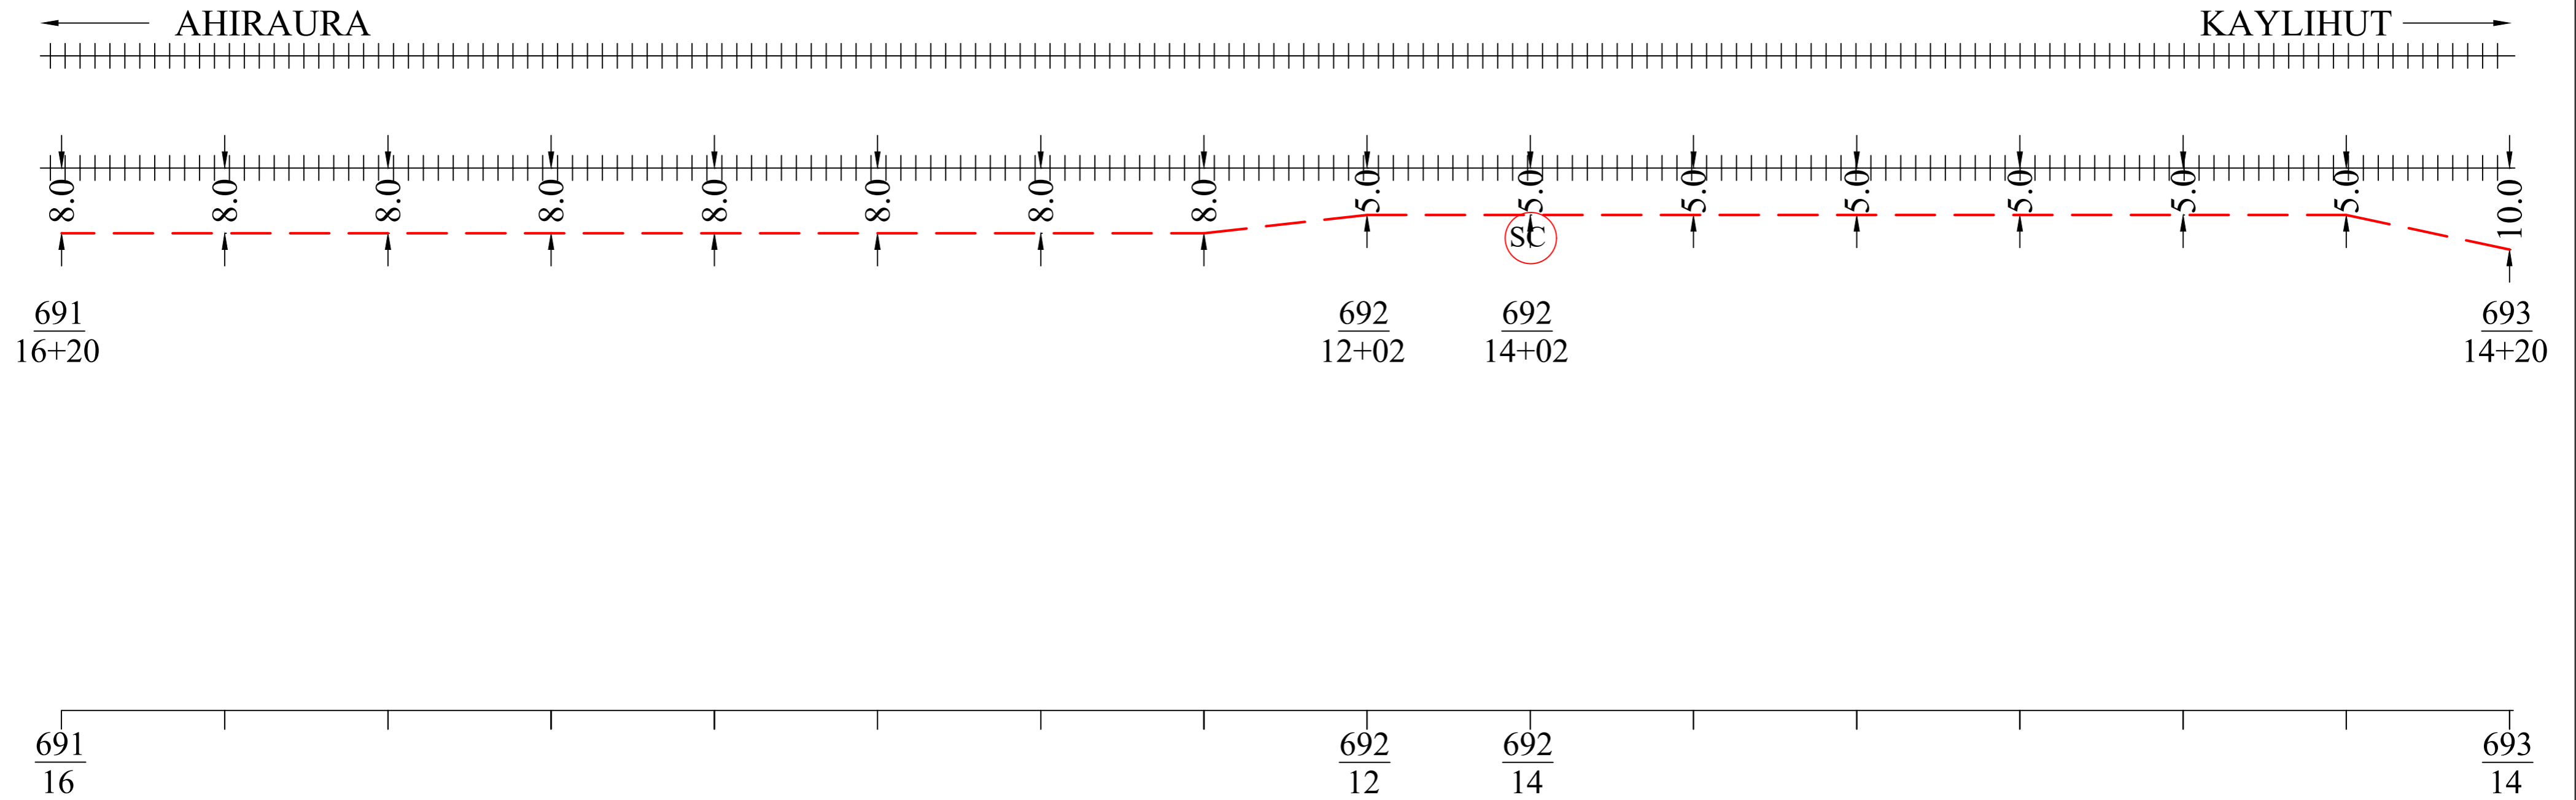

Note: - Laying of OFC as per RDSO L.NO.CBS/DCP/1, Dated 30.10.2009 & chief signal & Telecom Engineer/ALD L No. S&T/NCR/JPO(1/S&T/2012) Dated June 4, 2012)

APPROVED BY RAILWAYS

NORTH CENTRAL RAILWAY

RST INFOCOM PVT. LTD.

AS BUILT DIAGRAM OF 24F FOR THE ROUTE AHIRAURA Stn. TO KAYLIHUT Stn.

DRAWN BY:-
NAND KISHORE
Mob- +91 8960287304

CHECKED BY:-

ALL DIMENSION ARE IN METER (NOT TO SCALE)

LEGENDS

RAILWAY LINE	+++++
NEW LAID OFC	-----
OFC JOINT	-----○-----
LIMITED HIEGHT SUBWAY	
LC GATE/ LX GATE	x x
CULVERT/BRIDGE	┌───┐ └───┘
STATION	⊙
GI PIPE	○
DWC	
RAILWAY BOUNDRY	-----
EXISTING 6 QUAD CABLE	-----


TCIL/NEW DELHI

RCIL/PRYJ

SSE/T/PRYJ DIVISION

SSE/TELE/NCRPU/PRYJ

As built diagram of 24F laid between AHIRAURA ROAD Stn. to KAYLIHUT Stn.

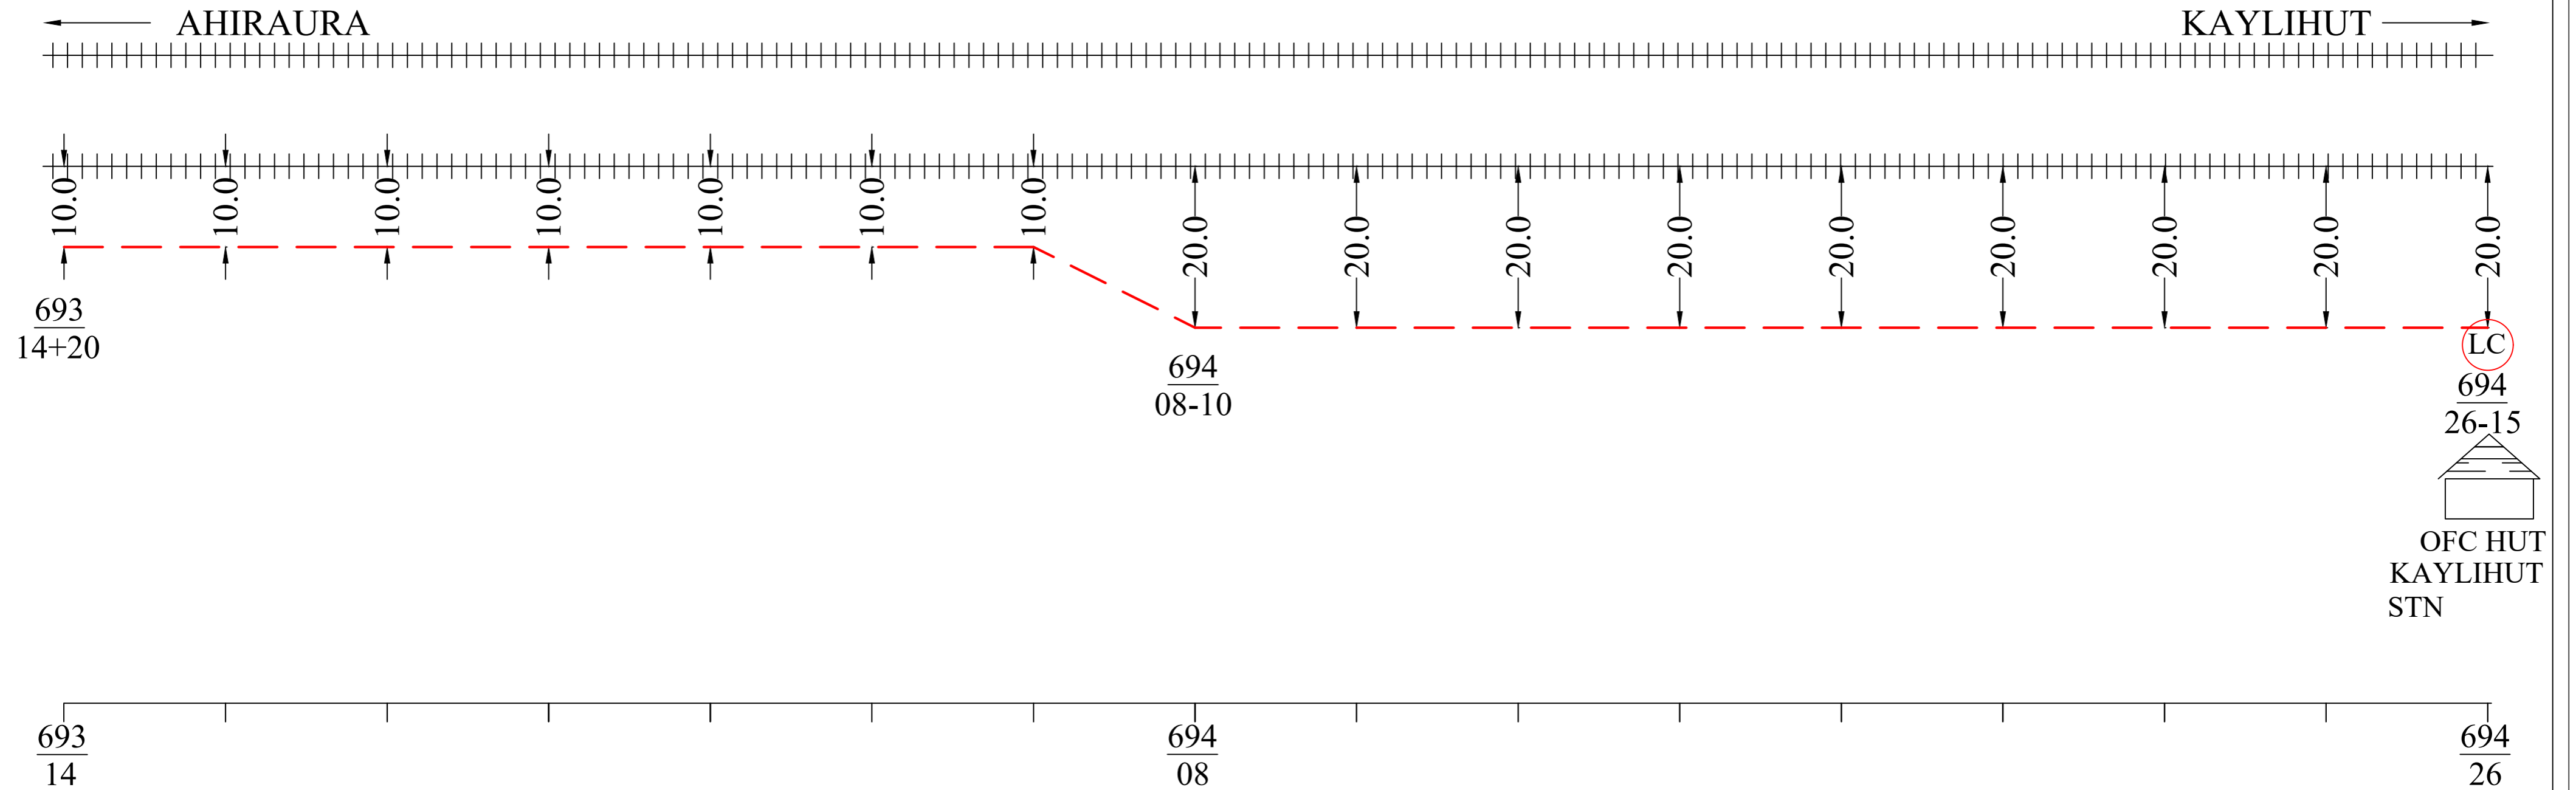

Note: - Laying of OFC as per RDSO L.NO.CBS/DCP/1, Dated 30.10.2009 & chief signal & Telecom Engineer/ALD L No. S&T/NCR/JPO(1/S&T/2012) Dated June 4, 2012)

APPROVED BY RAILWAYS

NORTH CENTRAL
RAILWAY

RST INFOCOM
PVT. LTD.

AS BUILT DIAGRAM OF
24F FOR THE ROUTE
AHIRAURA Stn. TO
KAYLIHUT Stn.

DRAWN BY:-
NAND KISHORE
Mob- +91 8960287304

CHECKED BY:-

ALL DIMENSION ARE IN METER
(NOT TO SCALE)

LEGENDS

RAILWAY LINE	+++++
NEW LAID OFC	-----
OFC JOINT	○
LIMITED HIEGHT SUBWAY	
LC GATE/ LX GATE	x
CULVERT/BRIDGE	— — — — —
STATION	⊙
GI PIPE	⊂
DWC	⊂⊂⊂⊂⊂
RAILWAY BOUNDRY	— — — — —
EXISTING 6 QUAD CABLE	⊂⊂⊂⊂⊂

TCIL/NEW DELHI

RCIL/PRYJ

SSE/T/PRYJ DIVISION

SSE/TELE/NCRPU/PRYJ