

06 - QUAD CABLE - ROUTE PLAN


(ORAI - ATA SECTION)

1241/7 TO 1257/0


JHANSI KANPUR

1241/7 TO 1243/2

Date-7-12-20
 polli-1241/2-4
 Jc1-1242/2+0m
 Jc2-1242/2+11m
 12422 TD-7m
 91.02.20
 OTRQ-15.5 km from area
 Jc1-1242/4+10m
 Jc2-1245/4+30m
 GATE NO. 184

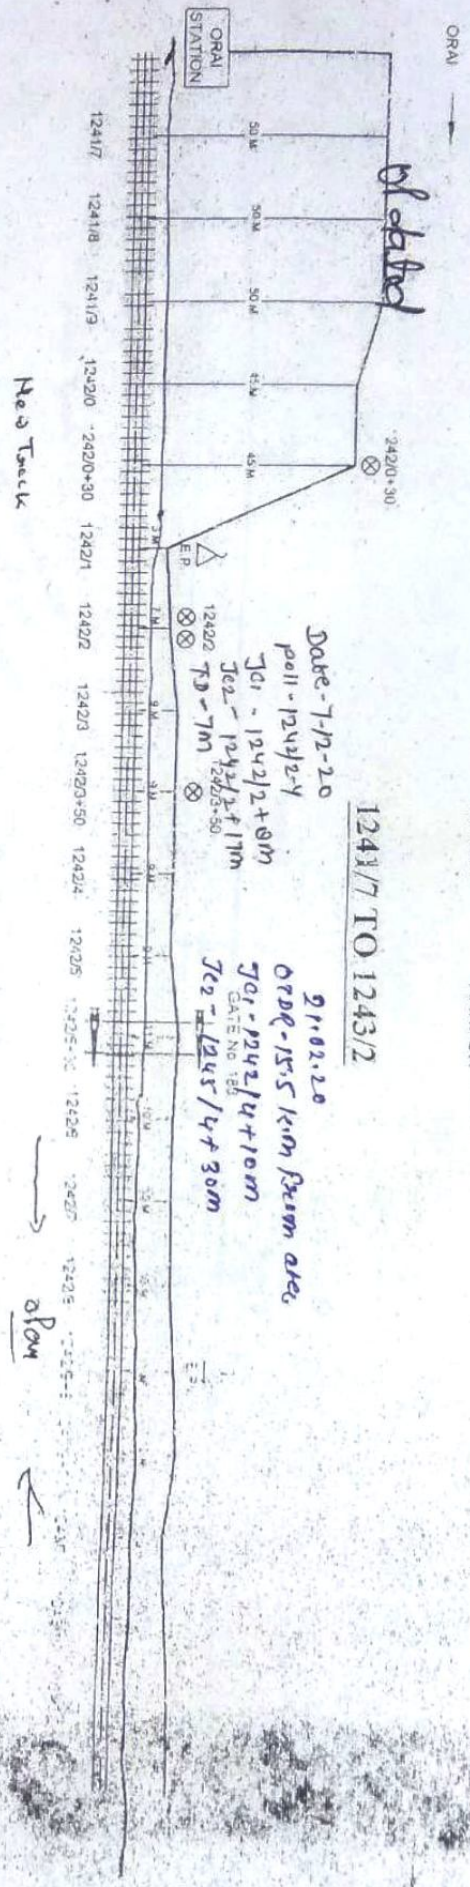

1243/3 TO 1245/0

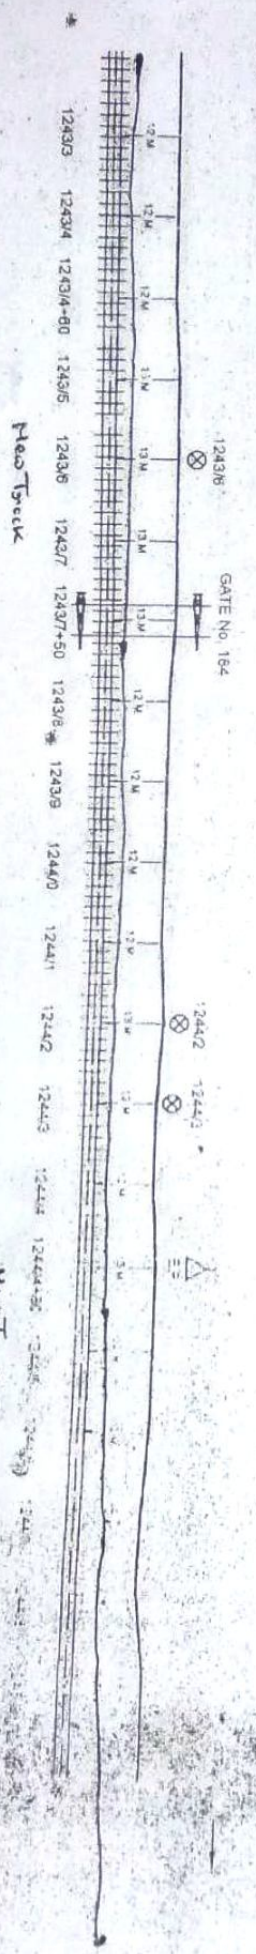

NOTE :- Distance of cable is from nearest rail

CABLE ROUTE PLAN

ITI LIMITED, LUCKNOW

PREPARED & CHECKED BY: *[Signature]*

△	EMERGENCY POST
⊗	NORMAL JOINTS
≡	GATE

APPROVED BY: *[Signature]*

SR.DISTE W.L.HS	SECTION	ORAI
SSTE/ARPMU/HHS	DRAWING NO	
SSECTOR/RAI	SHEET NO	

06 - QUAD CABLE - ROUTE PLAN

(ORAI - ATA SECTION)

1241/7 TO 1257/0

JHANSI KANPUR

ORAI

1245/1 TO 1246/7

New Track

1246/8 TO 1248/5

New Track

ORAI

Date - 31-10-20
Poll - 1247/2 + 10m
Jc1 - 1247/2 + 10m
Jc2 - 1247/2 + 10m

New Track

NOTE :- Distance of cable is from nearest rail

8/11/17

APPROVED BY

CABLE ROUTE PLAN

SR.DSTE/W./JHS

SECTION

ORAI TO ATA

SSTE/IRPMU/JHS

DRAWING NO

SSET/ORAI

SHEET NO

ITI LIMITED, LUCKNOW

PREPARED & CHECKED BY

Δ	EMERGENCY POST
⊗	NORMAL JOINTS
≡	GATE

Date - 8-4-16
 of - 12m
 5C-1 $\rightarrow$ 1248/5 = 25m
 5C-2 - 1248/10 = 35m

(ORAI - ATA SECTION)
1241/7 TO 1257/0

JHANSI


KANPUR —

1248/6 TO 1250/5


Case No. 187

Post → 01/11/2019
 PoA - 1249/26-28

४ NH पर बोर्ड का रोल-टेल के अन्तर्गत में
गंगा है।
५.६ km on road distance from ATR

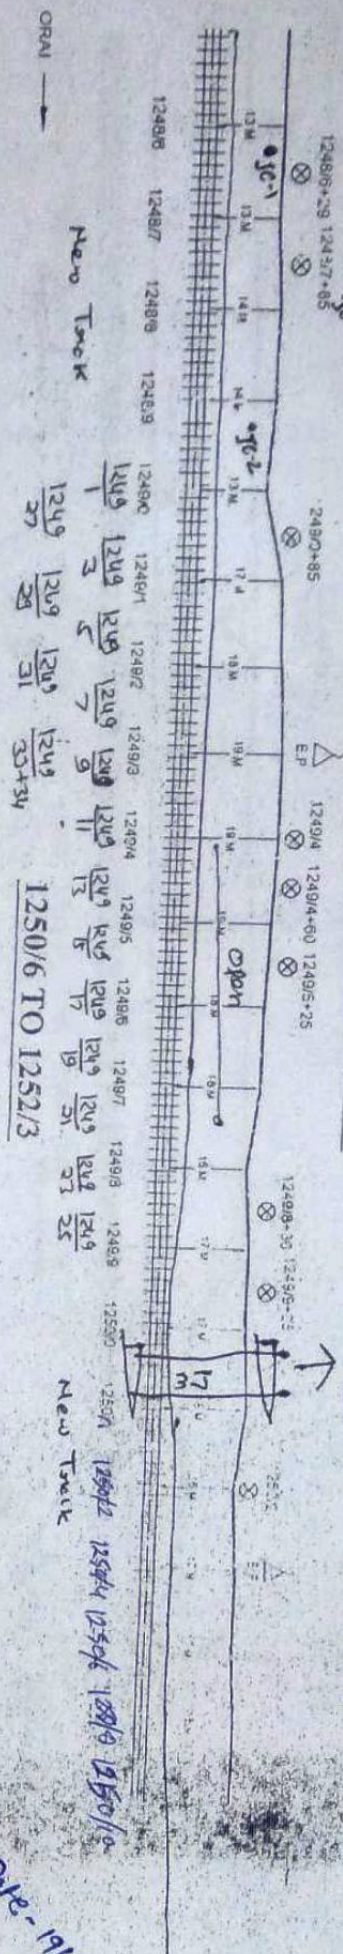

Date - 19/06/23

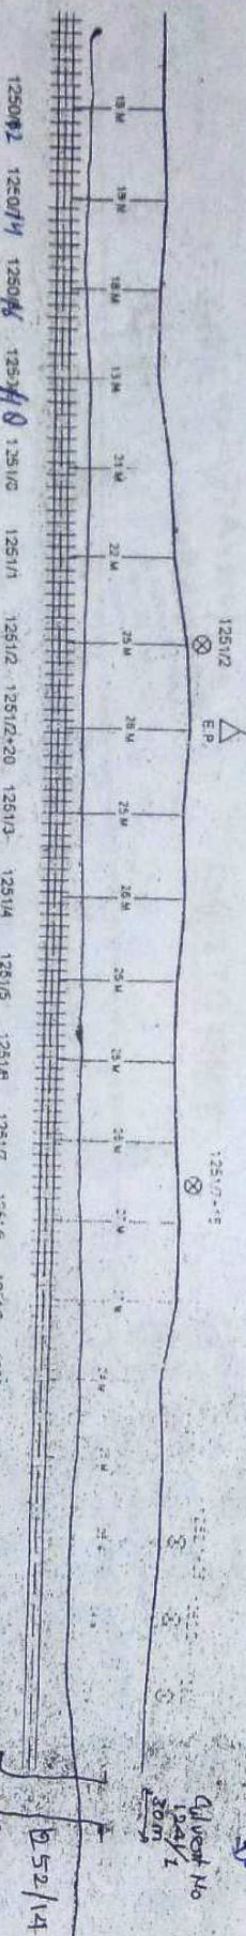

07/19 125048 125118 125118
Neo Treck 125118
Pd 125118 125118
Date 16/10/18
OTDR From
Defect - 80cm
MEMORANDUM

~~Chambers~~
4-6-42 - ~~Chambers~~ - A.A.
NOTE. - Dis.

NOTE - Distance of cable is from nearest rail

17/2/11
Office L

B52/14

Edamoni Mala

$$\begin{array}{r} 1281 \\ 1257 \end{array}$$

U

APPROVED BY

CABLE ROUTE PLAN

APPROVED BY		CABLE ROUTE PLAN	
SR.DSTE/W-L/H/S	SECTION	DRAWING NO.	
SSTE/REP/UT/H/S		SHEET NO.	

PREPARED & CHECKED BY:

	EMERGENCY POST
	NORMAL POINTS
	GATE

NOTE :- Distance of cable is from nearest rail

APPROVED BY

CABLE ROUTE PLANNING

APPROVED BY	CABLE ROUTE PLAN
SR.DS/TECH./JHS	SECTION
SSTE/ERPML/JHS	DRAWING NO.
SSET/ORAI	SHEET NO.

06 - QUAD CABLE - ROUTE PLAN


(OKAI - ATA SECTION)

1241/7 TO 1257/0

JHANSI

КАНПУР

1252/4 TO 1254/1

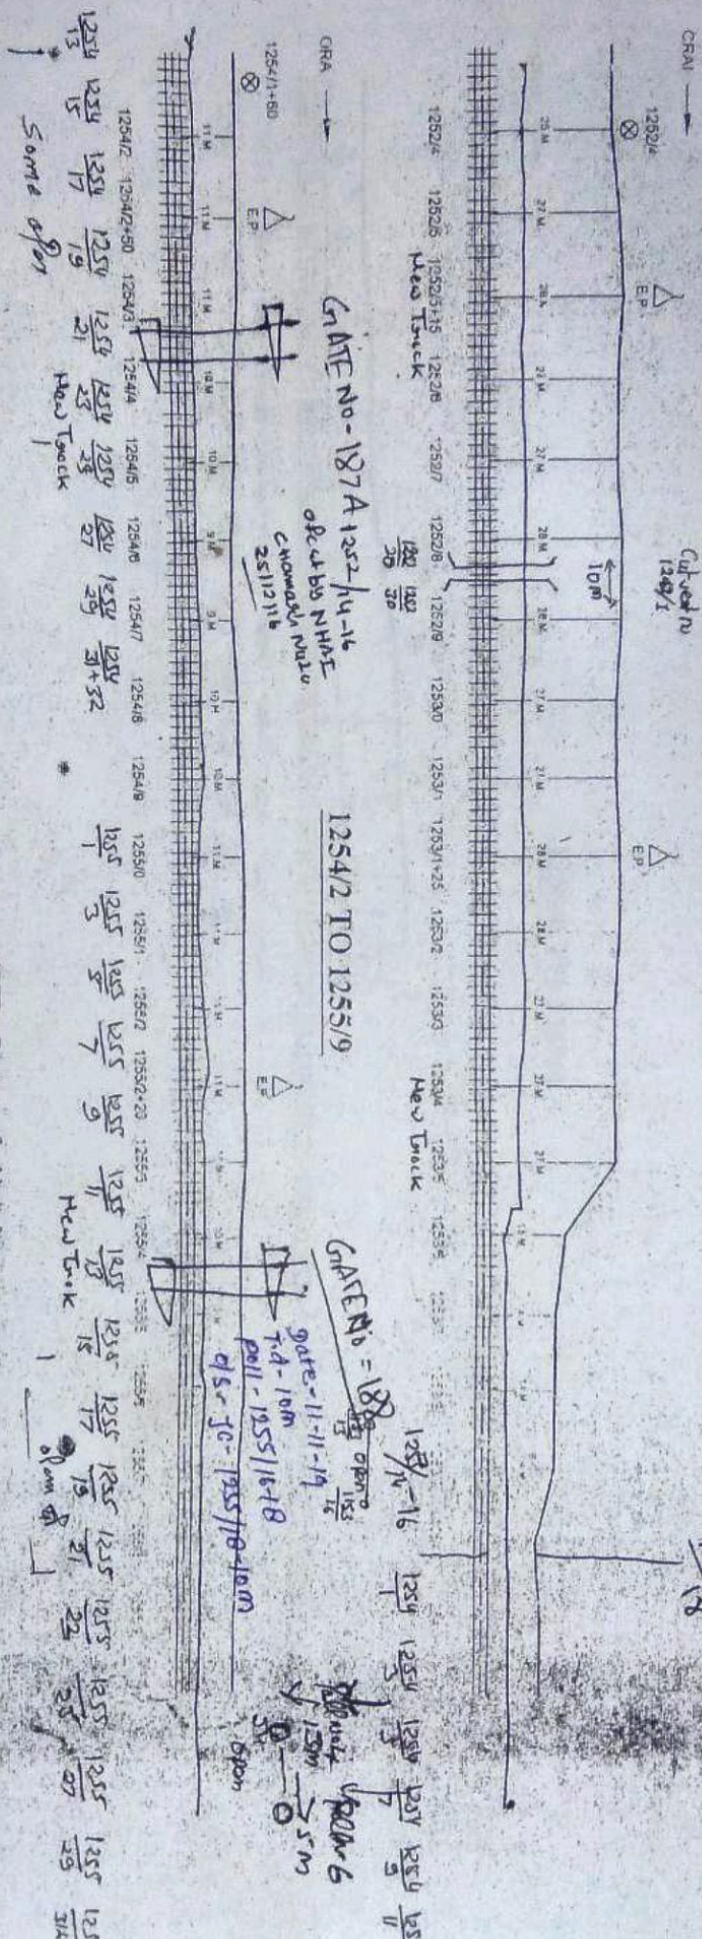

06 - QUAD CABLE - ROUTE PLAN


(ORAI - ATA SECTION)

1241/7 TO 1257/0

→ JHANSI

KANPUR →

1256/0 TO 1257/0

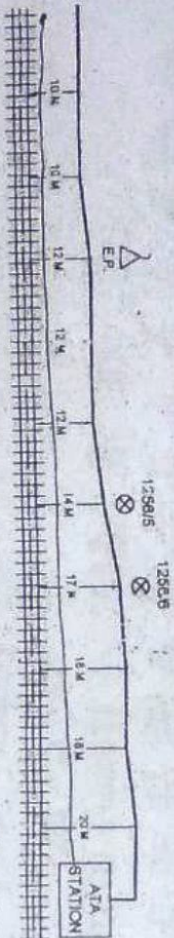

1256/0	1256/1	1256/2	1256/3	1256/4	1256/5	1256/6	1256/7	1256/8	1256/9	1257/0
1	3	5	7	9	11	13	15	17	19	21
New Track										

NOTE :- Distance of cable is from nearest rail.

ITI LIMITED, LUCKNOW

PREPARED & CHECKED BY

Δ	EMERGENCY POST
⊗	NORMAL JOINTS
■	GATE

APPROVED BY

CABLE ROUTE PLAN

SR.DISTE/W./JHS	SECTION	DRAWING NO.	SHEET NO.
SSTE/RP/MU/JHS			
SSE/T/ORAI			


(ATA TO KALPI SECTION)

1257/0 TO 1275/0

JHANSI

КАПРИ —

1257/0 TO 1275
JHANSI KANPUR
1257/0 TO 1258/9
date--5-5-19
GAIL No 189 1257/9-11
date--5-5-19

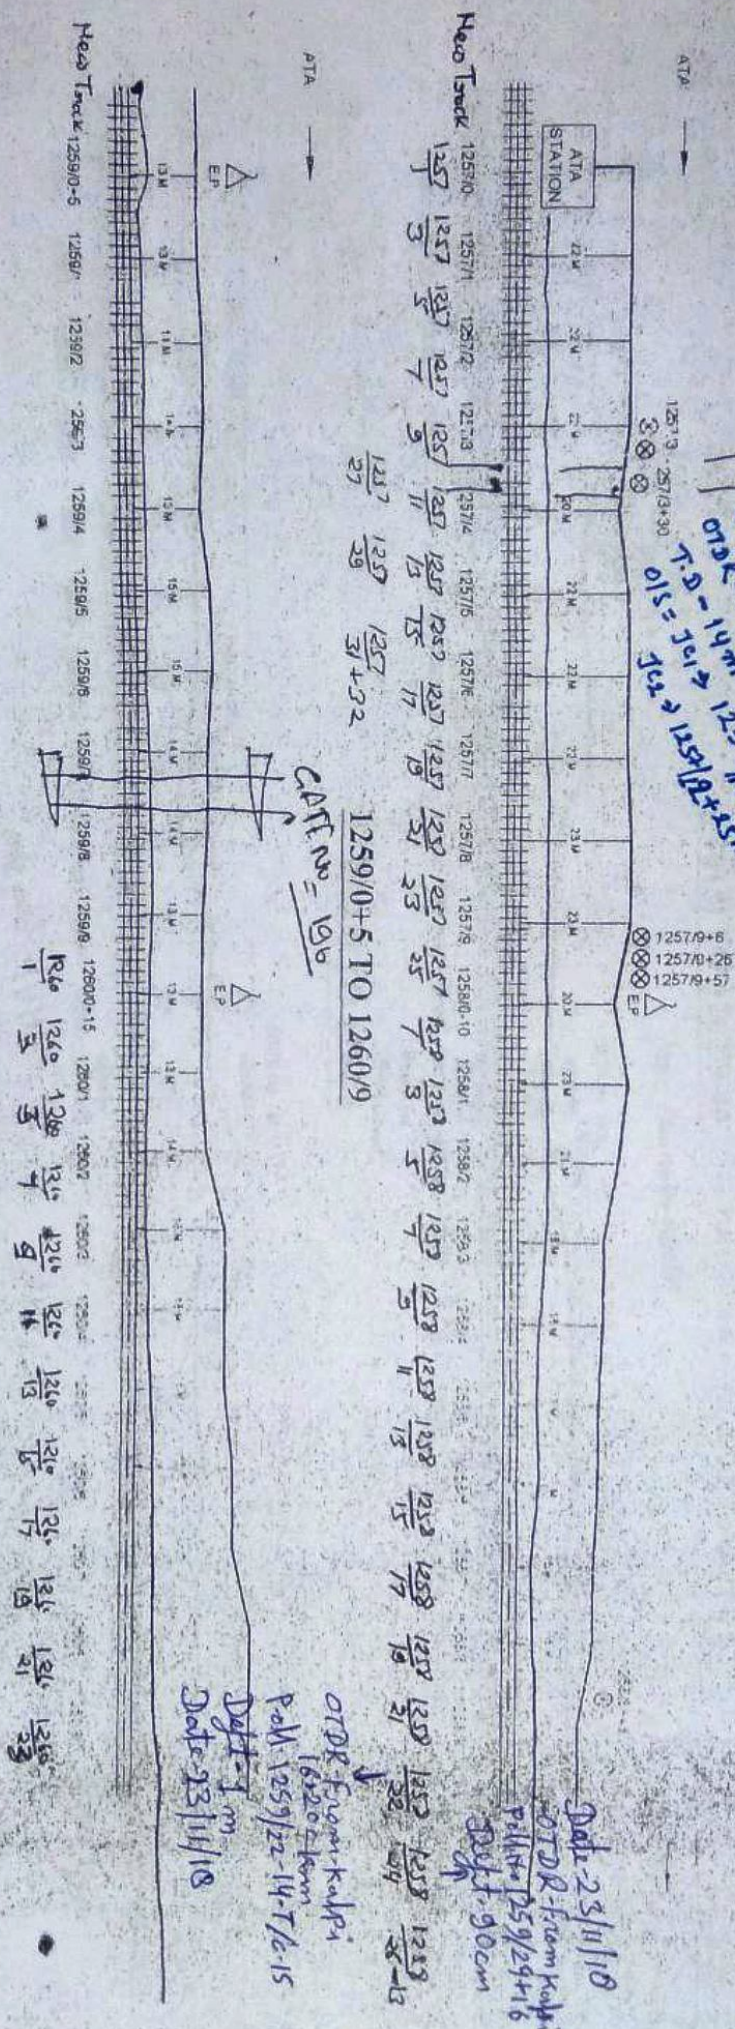

NOTE - Distance of cable is from nearest tail

APPROVED BY

CABLE ROUTE PLAN

	EMERGENCY POS
	NORMAL JOINTS
	GATE

SR.DSTE.W.LJHS

SECTION

AT4 TO HALL?

SYSTEM MOUTH

DRAFTING

SSE/TORAI

SHEET NO

06 - QUAD CABLE - ROUTE PLAN

(ATA TO KALPI SECTION)

1257/0 TO 1275/0

JHANSI


KANPUR

ATA

13/01/2020
1261/6-8
JCI - 1261/6+5m
JCI - 1261/4+25m

1261/0 TO 1262/9-40

OFC Fibre on the 04/05/17

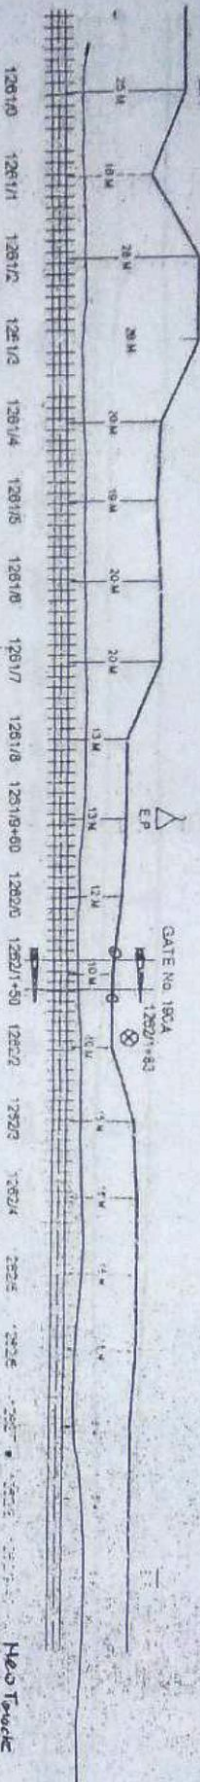


1263/0 TO 1264/8

Unmarked
Gated Cable

Hand Tracked

ATA

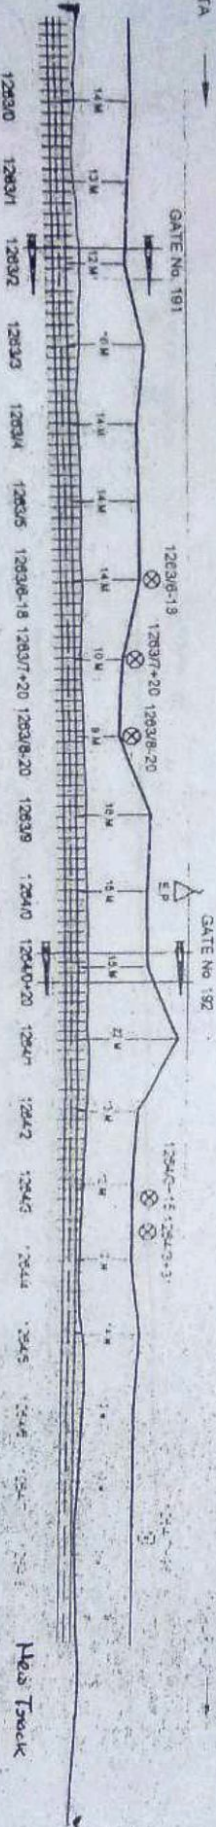

Hand Tracked

OFC cable 13/1/16
1263/24-22
NOTE - Distance of cable is from nearest rail

Hand Tracked

ITI LIMITED, LUCKNOW

PREPARED & CHECKED BY:

EMERGENCY POST
NORMAL PORTS
GATE

APPROVED BY:

CABLE ROUTE PLAN

SR.DISTE/W-L/HIS

SECTION

ATA TO KALPI

SSTE/DRP/L/HIS

DRAWING NO

1263/24-22

SSE/TORAI

SHEET NO


1263/24-22

06 - QUAD CABLE - ROUTE PLAN

(ATA TO KALPI SECTION)
1257/0 TO 1275/0


JHANSI KANPUR

1264/9 TO 1266/8

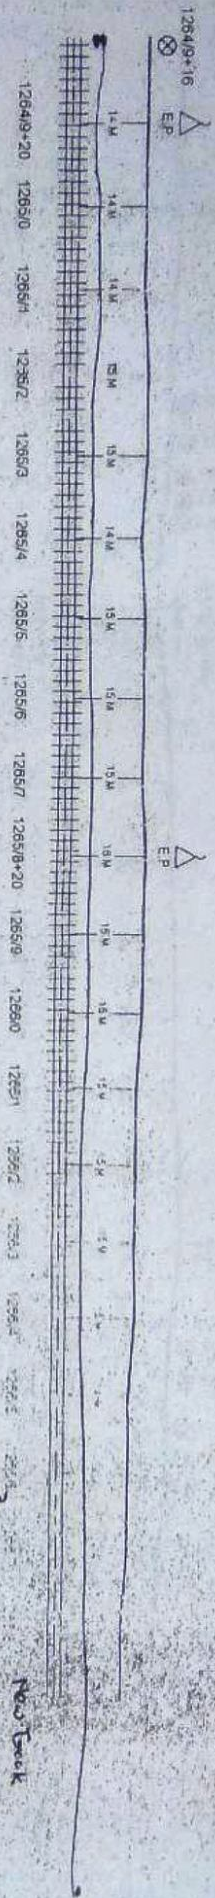

Usan Gadh
1265
Package 3

1266/8+25 TO 1268/6

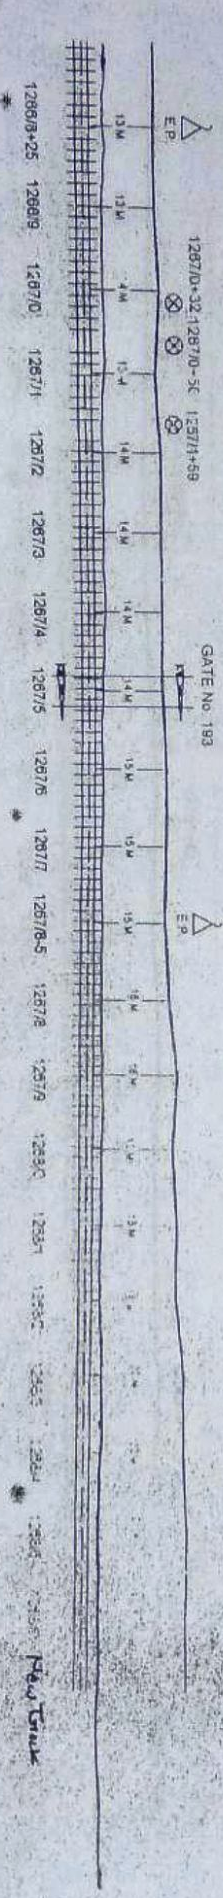

NOTE - Distance of cable is from nearest rail

PREPARED & CHECKED BY:	
	EMERGENCY JOINT
	NORMAL JOINTS
	GATE

APPROVED BY		CABLE ROUTE PLAN	
SR.DISTE.W./JHS		SECTION	ATA TO KALPI
SSTE/IRPMU/JHS		DRAWING NO.	
SSE/ORA/		SHEET NO.	

06 - QUAD CABLE - ROUTE PLAN


(ATA TO KALPI SECTION)
1257/0 TO 1275/0

31.1.20
R.O.D. (RWB) JHANSI KANPUR

1269/4-6

1268/7 TO 1270/3

GATE No. 194

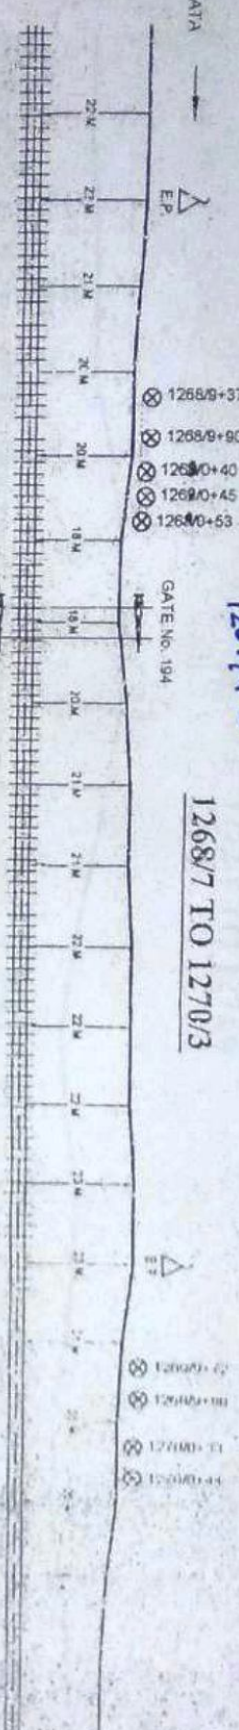

16.02.20 + 19.02.20 + 20/6/20


7.4.20 - 10m
361 - 1269/4 + 18m
362 - 1269/6 + 8m

1270/4 TO 1272/0

1269/16 - 1269/18
old cut 2/10/16
cut by IOW Railway

New Track

Date - 23/04/21
PMT - 1231/16-18
361 - 1231/16 + 7m
362 - 1231/18 - 5m

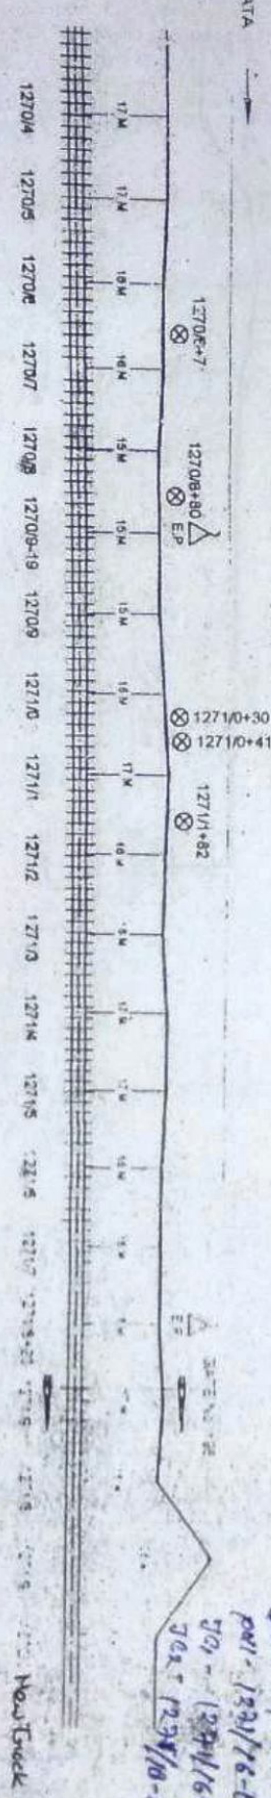

NOTE - Distance of cable is from nearest rail

ATA LIMITED, LUCKNOW

PREPARED & CHECKED BY

EMERGENCY ROUTE	Δ
NORMAL ROUTES	⊗
GATE	≡

APPROVED BY

CABLE ROUTE PLAN


SR.DSTE/W-L/HS	SECTION	ATA TO KALPI
SSTE/IRPMA/HS	DRAWING NO.	
SSE/IRAI	SHEET NO.	

06 - QUAD CABLE - ROUTE PLAN

(ATA TO KALPI SECTION)
1257/0 TO 1275/0

→ JHANSI KANPUR →

1272/1 TO 1274/0

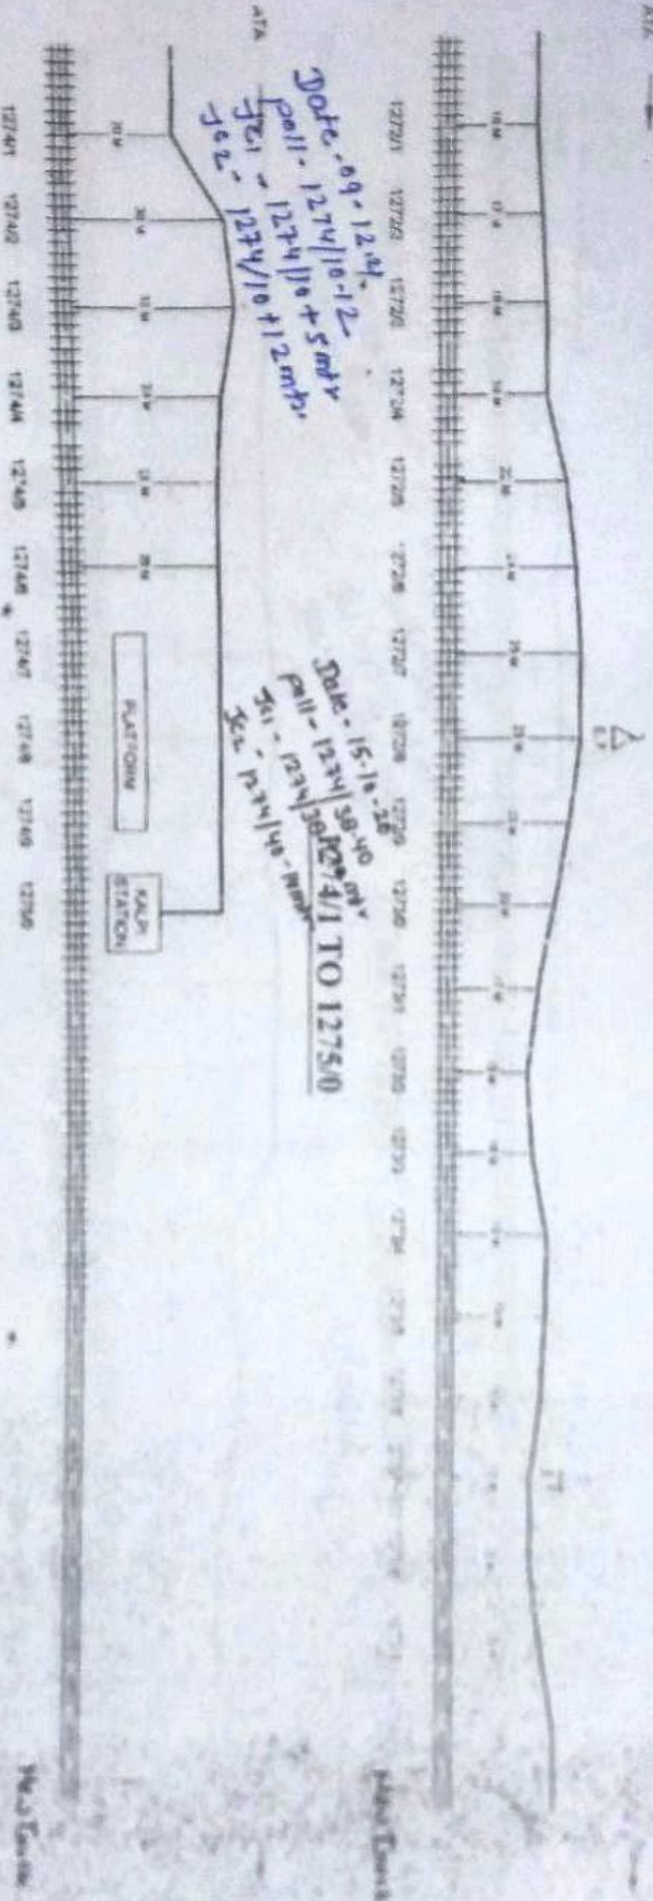

NOTE - Distance of cable is given as per 'G'.

APPROVED BY

CABLE ROUTE PLAN

SR.DISTE/W-LHS

SECTION

ATA TO KALPI

SSTE/DPN/PHS

DRAWING NO

1274/1

SSE/ORA

SHEET NO

1274/1

ITI LIMITED, LUCKNOW

PREPARED & CHECKED BY


DATE	12/11/11
REMARKS	12/11/11

06 - QUAD CABLE - ROUTE PLAN

(KALPI TO CHOURAH SECTION)
1275/0 TO 1280/6

— JHANSI — KANPUR —

1275/0 TO 1276/7

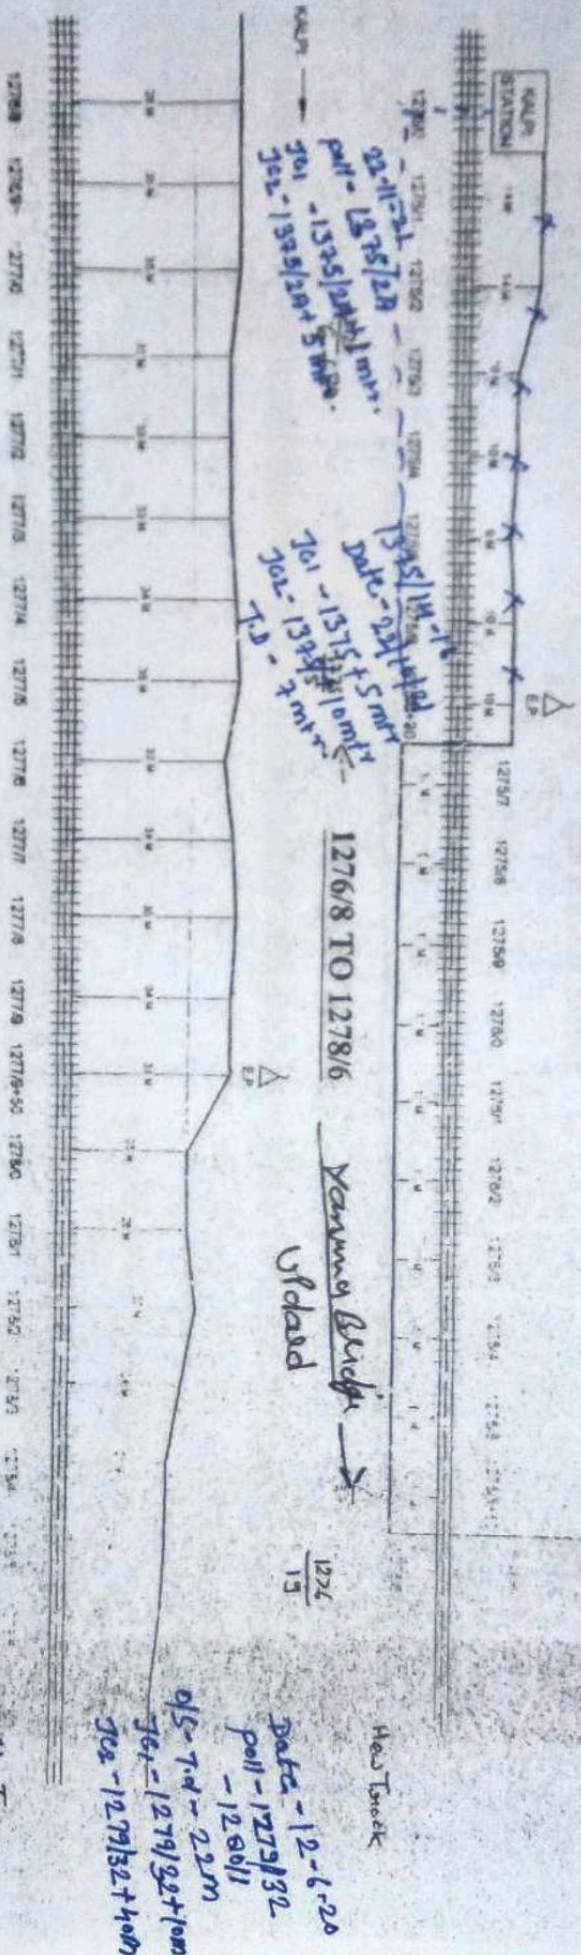

NOTE :- Distance of cable is from nearest rail.

APPROVED BY

CABLE ROUTE PLAN

SR.DS/TE/W./JHS

SECTION

KALPI TO CHOURAH

SS/TE/PMU/JHS

DRAWING NO

SS/TE/ORAI

SHEET NO

ITI LIMITED, LUCKNOW

PREPARED & CHECKED BY


06 - QUAD CABLE - ROUTE PLAN

(KALPI TO CHOURAH SECTION)

1275/0 TO 1280/6

JOINED KALPI

1278/8 TO 1280/6

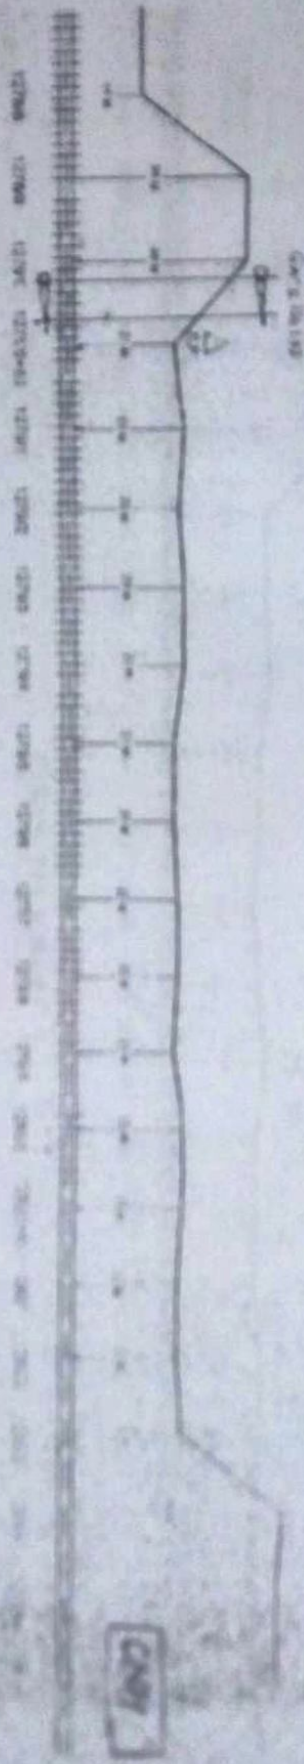

ITI LIMITED, LUCKNOW

PREPARED & CHECKED BY

DATE	REVISION	INTERVIEW

NOTE - Distance of cable is from center line

APPROVED BY

CABLE ROUTE PLAN

SIR DISTRICT	SECTION	NAME OF THE CABLE
SIR DISTRICT	SECTION	NAME OF THE CABLE

(CHOUBRAH - PUKHIRANYA SECTION)

12807 TO 12890


W. A. Nijhuis

1280/6 TO 1282/4

0.024-01 paces per
pace - 120/5 = 24
30 - 120/5 = 24
30 - 120/5 = 24

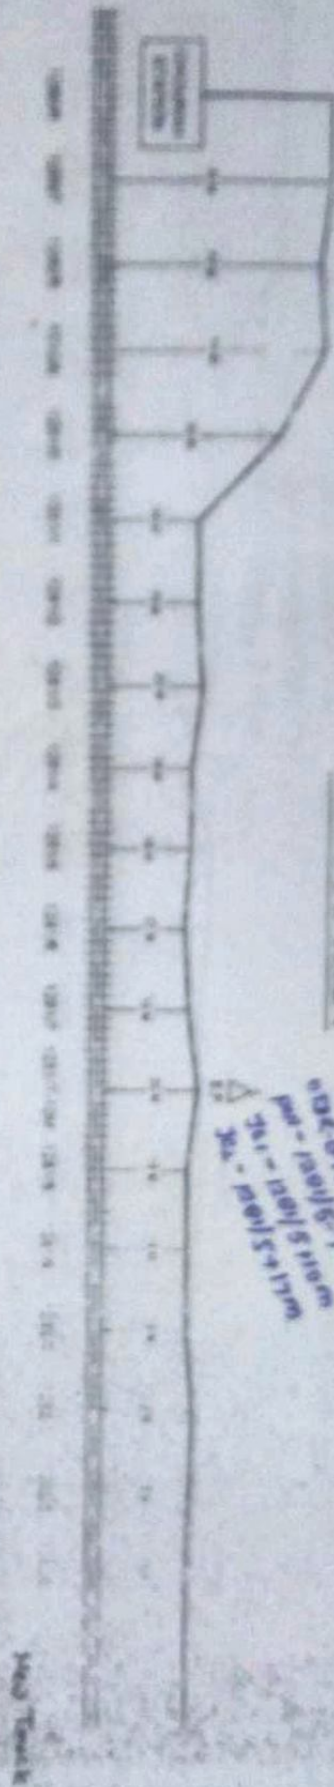

1282/5 TO 1284/1

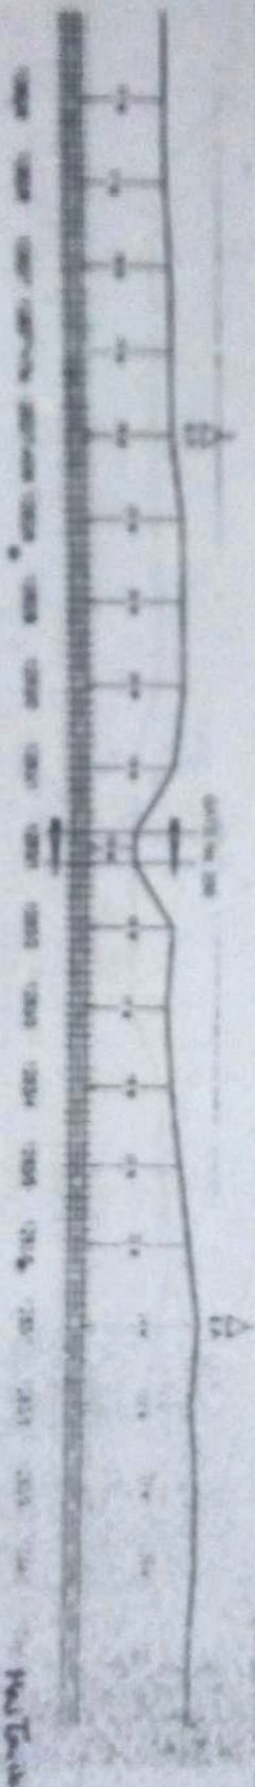

NOTE - Distance of cable is from nearest rail

APPROVED BY

CABLE ROUTE PLAN

SHEET NO.	
DRAWING NO.	
SECTIONAL	
ASSEMBLY	
DATE	

(CHOURAH - PUKHRANYA SECTION)

1280/7 TO 1289/0

— JHANSI — KANPUR —


CHOURAH

1284/2 TO 1285/8

Date - 10-02-21

Pen- 1284/20-22


$\text{Jc}_2 - 1284/20 + 1200$

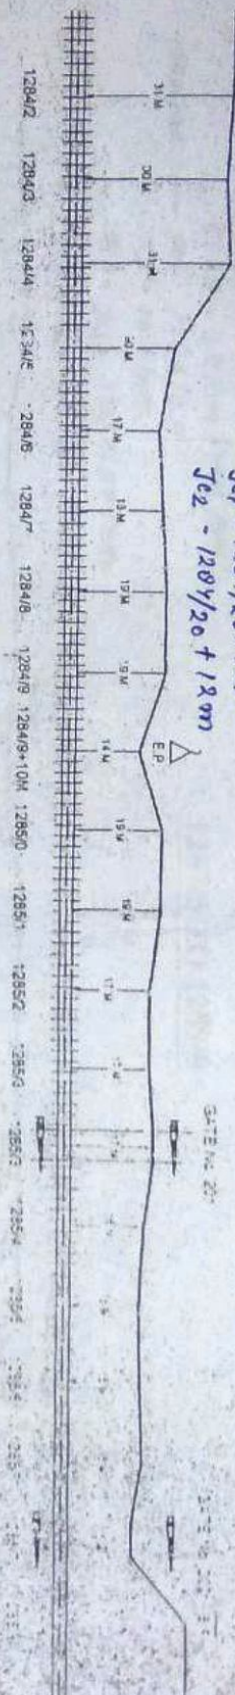

Heu Tjock

CHOURAH

1285/9 TO 1287/4

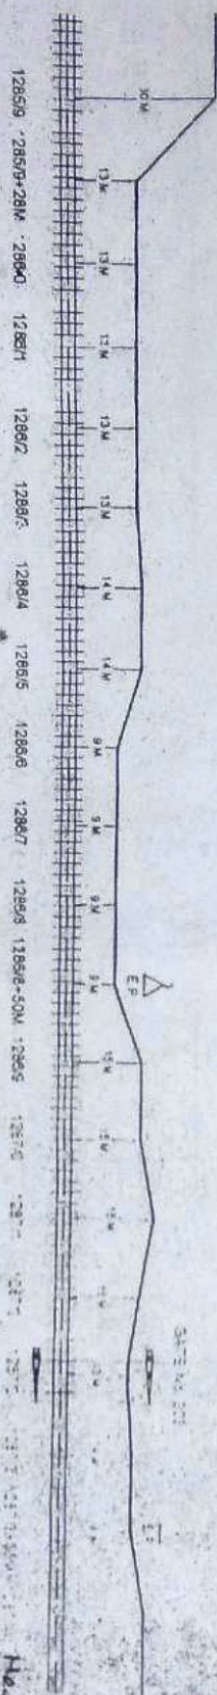

Head Tack

NOTE: Distance of cable is from nearest wall.

APPROVED BY

CABLE ROUTE PLAN

APPROVED BY	CABLE ROUTE PLAN
SR.DSTEWM/JHS	SECTION
SSTEIRPM/JHS	DRAWING NO.
SSE/ORA1	SHEET NO.

दे. इ. टी. लिमिटेड, लखनऊ

PREPARED & CHECKED BY:

EMERGENCY POST

⊗
NORMAL JOINTS

1

06 - QUAD CABLE - ROUTE PLAN


(CHOURAH - PUKHRANYA SECTION)

1280/7 TO 1289/0

— JHANSI — KANPUR —

Date - 10-11-20
0729R - 2.0 km from PHN
PHN - 1287/6-8
T.3 - 10.4 km
0/5 - Jc1 - 1287/8 + 17m
Jc2 - 1287/6 + 20m

1287/5 TO 1289/0

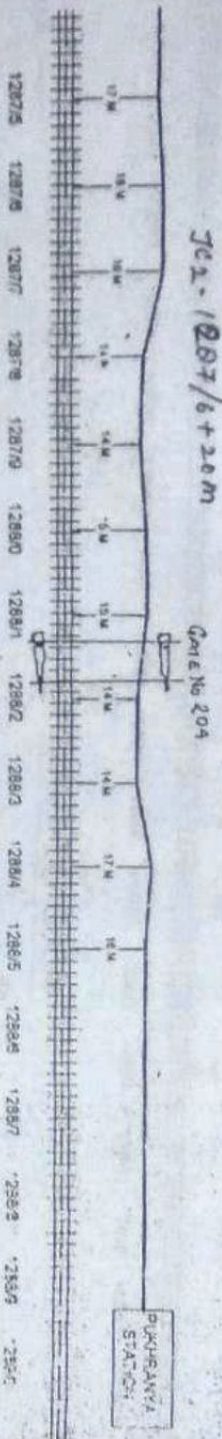

NOTE :- Distance of cable is from nearest rail

ITL LIMITED, LUCKNOW	
PREPARED & CHECKED BY	
Δ	EMERGENCY POST
⊗	NORMAL JOINTS
≡	GATE

APPROVED BY		CABLE ROUTE PLAN	
SR.DSTE/W-JHS	SECTION	CHOURAH - PUKHRANYA	
SSTE/IRPM/JHS	DRAWING NO	0729R	
SSE/OKAI	SHEET NO	01	

06 - QUAD CABLE - ROUTE PLAN

(PUKHRAYA - LALPUR SECTION)

1289/0 TO 1304/2

→ JHANSI KANPUR →

PUKHRAYA →


1289/1 TO 1291/0

Date - 13-12-26

73-17m

761-1269/20+2m


763-1269/26+7m

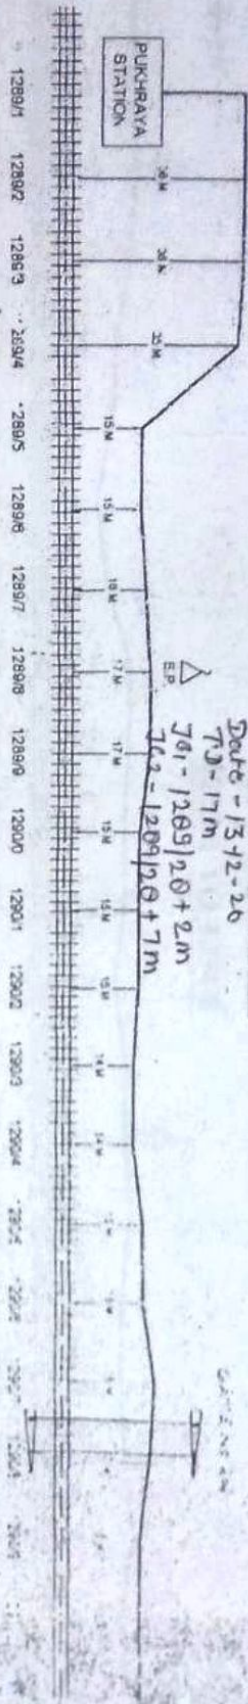

Head Trench

PUKHRAYA →

1291/1 TO 1293/0

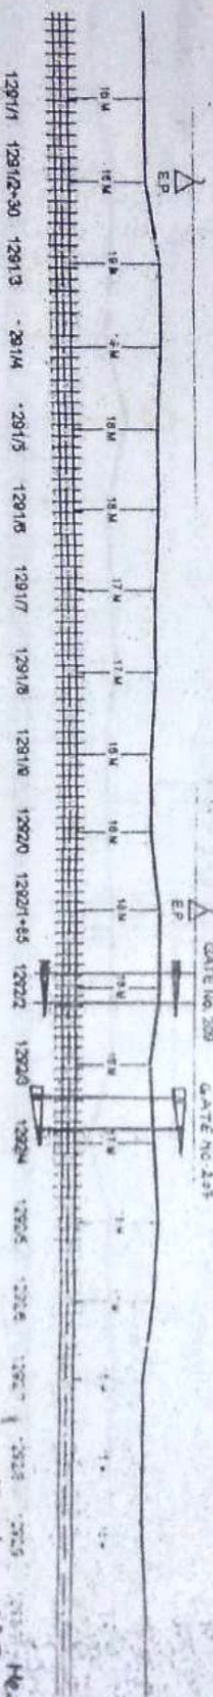

NOTE :- Distance of cable is from nearest rail.

1289/28 1289/30
Cable D/M/2
141/71M

ITI LIMITED, LUCKNOW

PREPARED & CHECKED BY:

EMERGENCY PORT
NORMAL PORTS
GATE

APPROVED BY

CABLE ROUTE PLAN

SR.DISTE/W-L/H/S	SECTION	PUKHRAYA TO LALPUR
SSTE/EP/MU/H/S	DRAWING NO	
SSE/TORAI	SHEET NO	

PREPARED & CHECKED BY:

△	EMERGENCY POST
⊗	NORMAL JOINTS
≡	DATE

06 - QUAD CABLE - ROUTE PLAN

(PUKHRAVA - LALPUR SECTION)


1289/0 TO 1304/2

→ JHANSI KANPUR →

1300/6 TO 1302/5

New OFC

1301/26 + 18 m

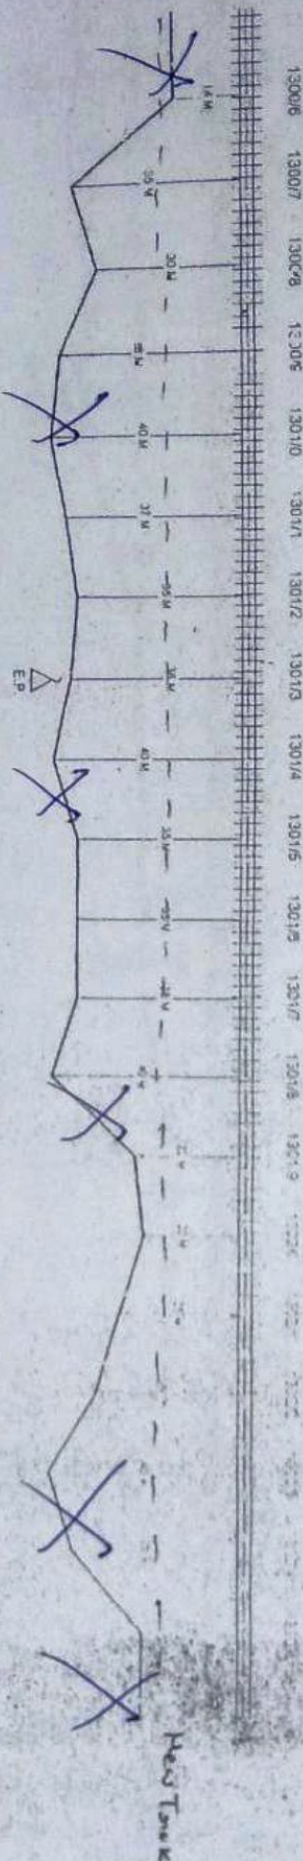

NOTE :- Distance of cable is from nearest P.O.

APPROVED BY

CABLE ROUTE PLAN

SR.DISTE/W./JHS	SECTION	PUKHRAVA TO LALPUR
SSTE/IRPMC/JHS	DRAWING NO.	
SSET/ORAI	SHEET NO.	

06 - QUAD CABLE - ROUTE PLAN


(PUKHRAVA - LALPUR SECTION).

1289/0 TO 1304/2

JHANSI KANPUR

PUKHRAVA

1302/5 TO 1304/3

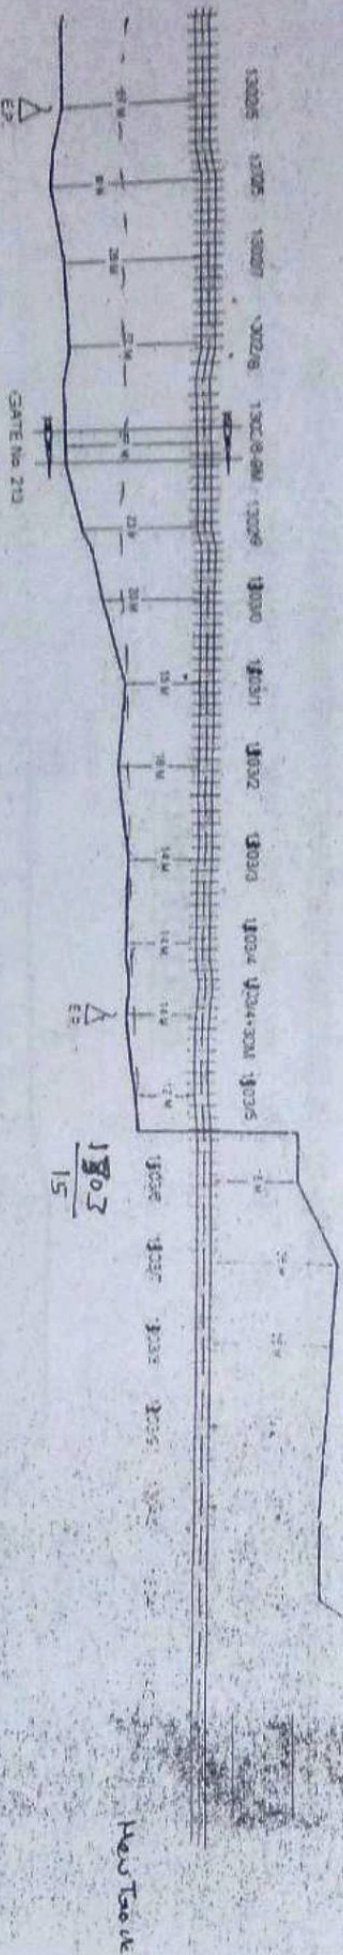

1500
15

H. S. T. S.

18/2/12
H. S. T. S.

NOTE :- Distance of cable is from nearest rail

APPROVED BY

CABLE ROUTE PLAN

SRDSTE/W-LHS	SECTION	PUKHRAVA TO LALPUR
SSETRPMU/JHS	DRAWING NO	
SSE/TORAI	SHEET NO	

ITI LIMITED, LUCKNOW

PREPARED & CHECKED BY:

EMERGENCY POST	Δ
NORMAL JOINTS	⊗
GATE	

06 - QUAD CABLE - ROUTE PLAN

(LALPUR - PAMAN SECTION)

1304/0 TO 1318/3

→ JHANSI

KANPUR →

LALPUR →


1304/0 TO 1305/9

Date - 16-09-20
 PWD NO - 1304/26-28
 9/5 - T4-15M
 301 - 1304/26+12m
 302 - 1304/26+16m

LALPUR →

1306/0 TO 1307/9

Head Office

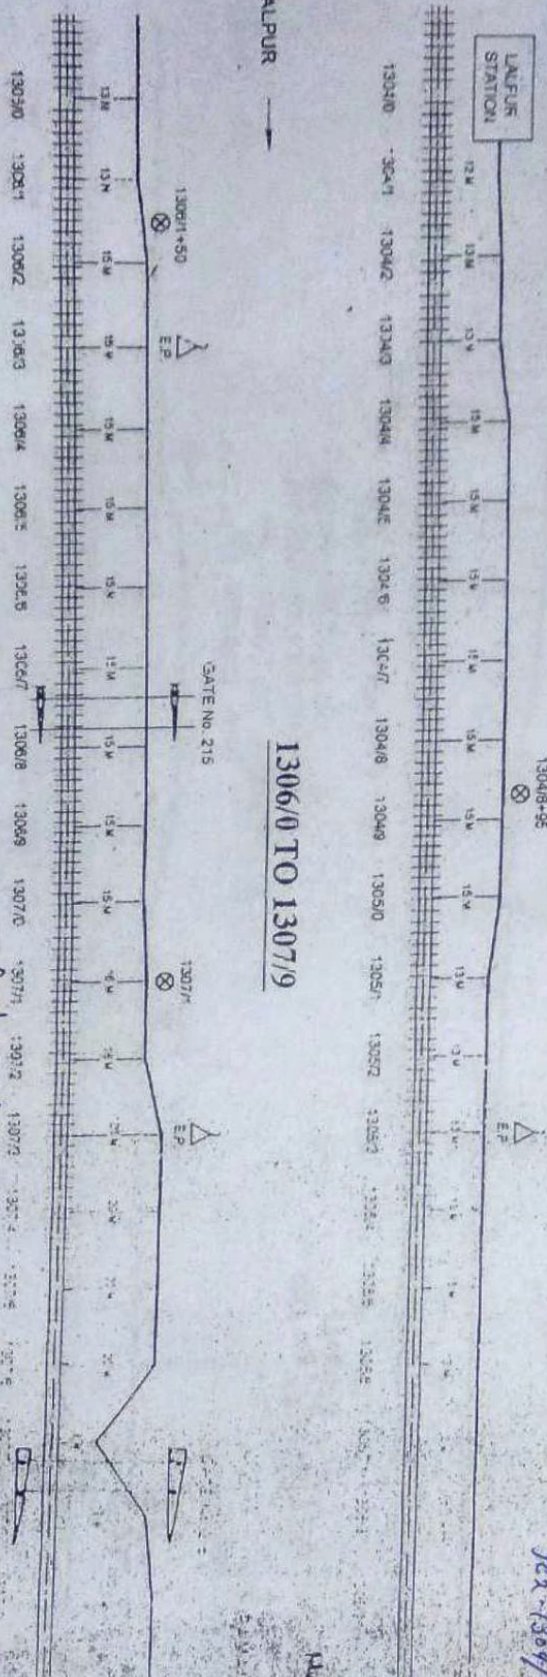

NOTE : Distance of cable is from nearest rail

* affected 1307/25-32
 24/3/16
 1307/00
 affected 1307/25-32
 24/3/16
 1307/00
 affected 1307/25-32
 24/3/16
 1307/00

affected 1307/25-32
 24/3/16
 1307/00
 affected 1307/25-32
 24/3/16
 1307/00

ITI LIMITED, LUCKNOW

PREPARED & CHECKED BY:

Δ	EMERGENCY POST
⊗	NORMAL JOINTS
≡	GATE

APPROVED BY

CABLE ROUTE PLAN

SR.DISTE-W-LJHS	SECTION	LALPUR TO PAMAN
SSTE/RPML/JHS	DRAWING NO	
SSE/TORAI	SHEET NO	

PREPARED & CHECKED BY:

Δ	EMERGENCY POST
⊗	NORMAL JOINTS
⊥	GATE

Poll - 1308/3-5
 OTR - 41.6 km from CMB
 Td - 14 m
 o/s - 301 - 1308/9+50m
 302 - 1308/9+50m


06 - QUAD CABLE - ROUTE PLAN

(LALPUR - PAMAN SECTION)
1304/0 TO 1318/3.

JHANSI KANPUR

LALPUR


1308/0 TO 1309/9

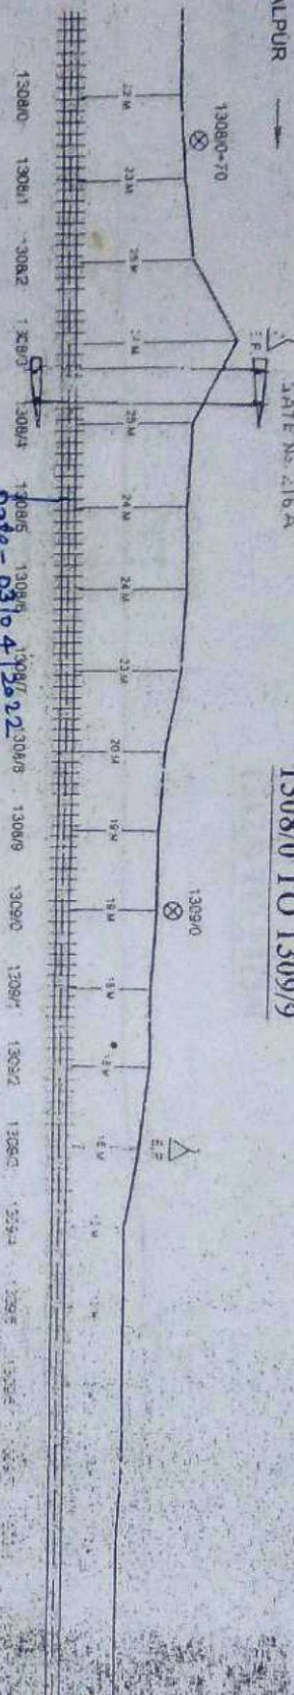

LALPUR

GATE No. 218

Poll No - 1308/14-16
 OTR - 40.7 km from CMB
 o/s - 1308/14 - 1310/0 TO 1311/9
 d/s - 1308/16 - 13

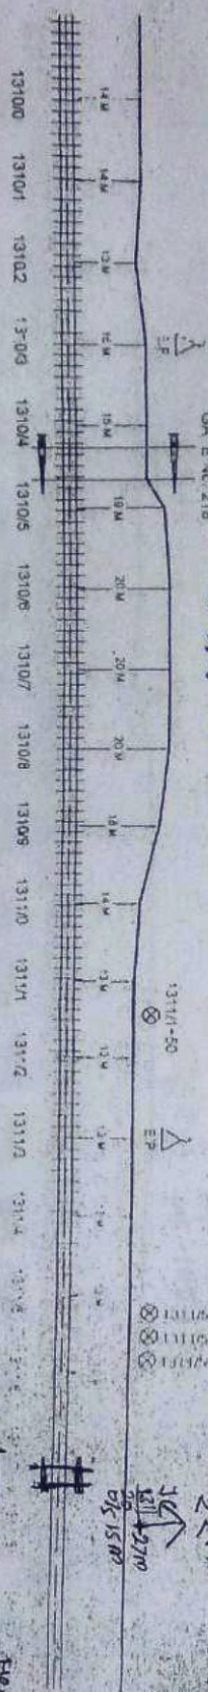

NOTE - Distance of cable is from nearest rail

131/21-5 m
 2C
 OTR from 8m2
 21.4 km

APPROVED BY

CABLE ROUTE PLAN

SRDSTE W/LHS	SECTION	LALPUR TO PAMAN
SSTE/RPML/HHS	DRAWING NO.	
SSE/TORAI	SHEET NO.	

PREPARED & CHECKED BY

Δ	EMERGENCY POST
⊗	NORMAL POSTS
≡	GATE

06 - QUAD CABLE - ROUTE PLAN

(LALPUR - PAMAN SECTION)


1304/0 TO 1318/3

→ JHANSI KANPUR →

LALPUR →

GATE No. 220


1312/0 TO 1313/9

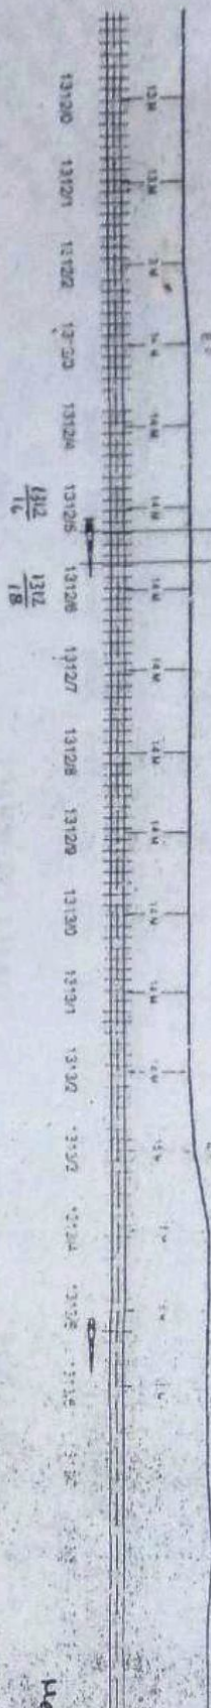

LALPUR →

GATE No. 222

1314/0 TO 1315/9

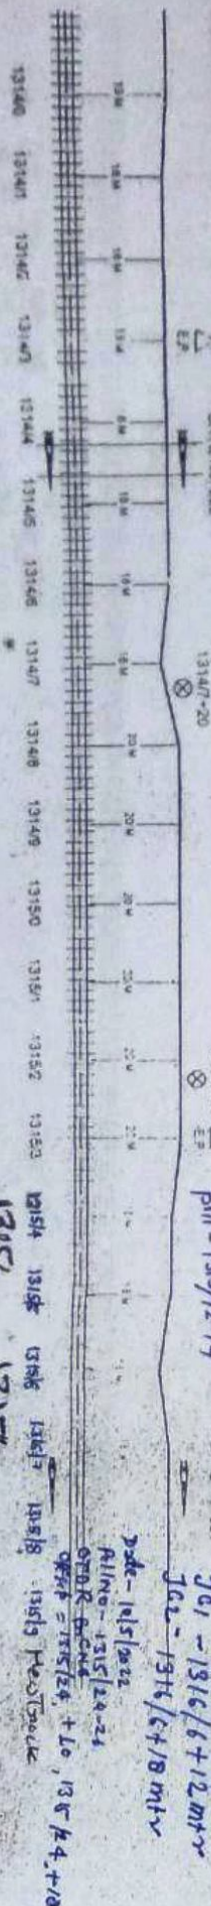

1314/0 TO 1315/9

NOTE - Distance of cable is from nearest rail

APPROVED BY

CABLE ROUTE PLAN

SR.DISTE W. LHS	SECTION	LALPUR TO PAMAN
SSE/IRPMU/JHS	DRAWING NO	
SSE/TORAI	SHEET NO	

03/03/22
JG1 - 1315/12 + 12 mtr
P111 - 1315/12-14

Date - 29-01-22
P01 - 1316/6-8
JG1 - 1316/6 + 12 mtr
JG2 - 1316/6 + 18 mtr

1315/12 - 1315/14
1315/12 - 1315/14
1315/12 - 1315/14

Open 29/3/16
Sumit

06 - QUAD CABLE - ROUTE PLAN

(LALPUR - PAMAN SECTION)

1304/0 TO 1318/3

JHANSI

KANPUR

LALPUR

1316/0 TO 1317/9

13182-20
EP

GATE No. 224

13179-30
EP

1317/16, 1317/18

51

Heater


1317/26

OFC cut
7-03-18
OTOR = 1.25 km from Paman
OHE 1317
14-15

Block
21-2-20
T-Joint Chamber
Behind Paman hut.

1318/0 TO 1318/3

PAMAN
STATION

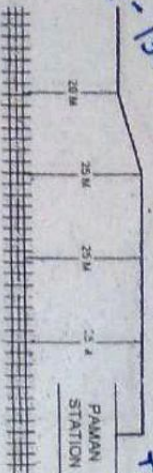

13180 13181 13182 13183
1318 1318 1318 1318
4 31 7 10 13
OTDR at 24/13/16
OTDR at Paman 12/52

OTDR at Paman 12/52

NOTE - Distance of cable is from nearest rail

APPROVED BY

CABLE ROUTE PLAN

SR.DISTE/W-IJHS

Signature

SECTION

LALPUR TO PAMAN

SSTE/IRPMU/JHS

Signature

DRAWING NO

SSE/ORA/

Signature

SHEET NO

ITI LIMITED, LUCKNOW

PREPARED & CHECKED BY

Δ	EMERGENCY POST
⊗	NORMAL JOINTS
≡	GATE

06 - QUAD CABLE - ROUTE PLAN

(PAMAN - BHIMSEN SECTION)
1318/4 TO 1333/6

PAMAN

JHANSI

KANPUR

1318/4 TO 1320/3

1319/2-3

PAMAN STATION


PAMAN

1318/24 - 1318/26
340116 C/LB/D
P/NL

1320/4 TO 1322/3

1321/2-3

1321/2-10

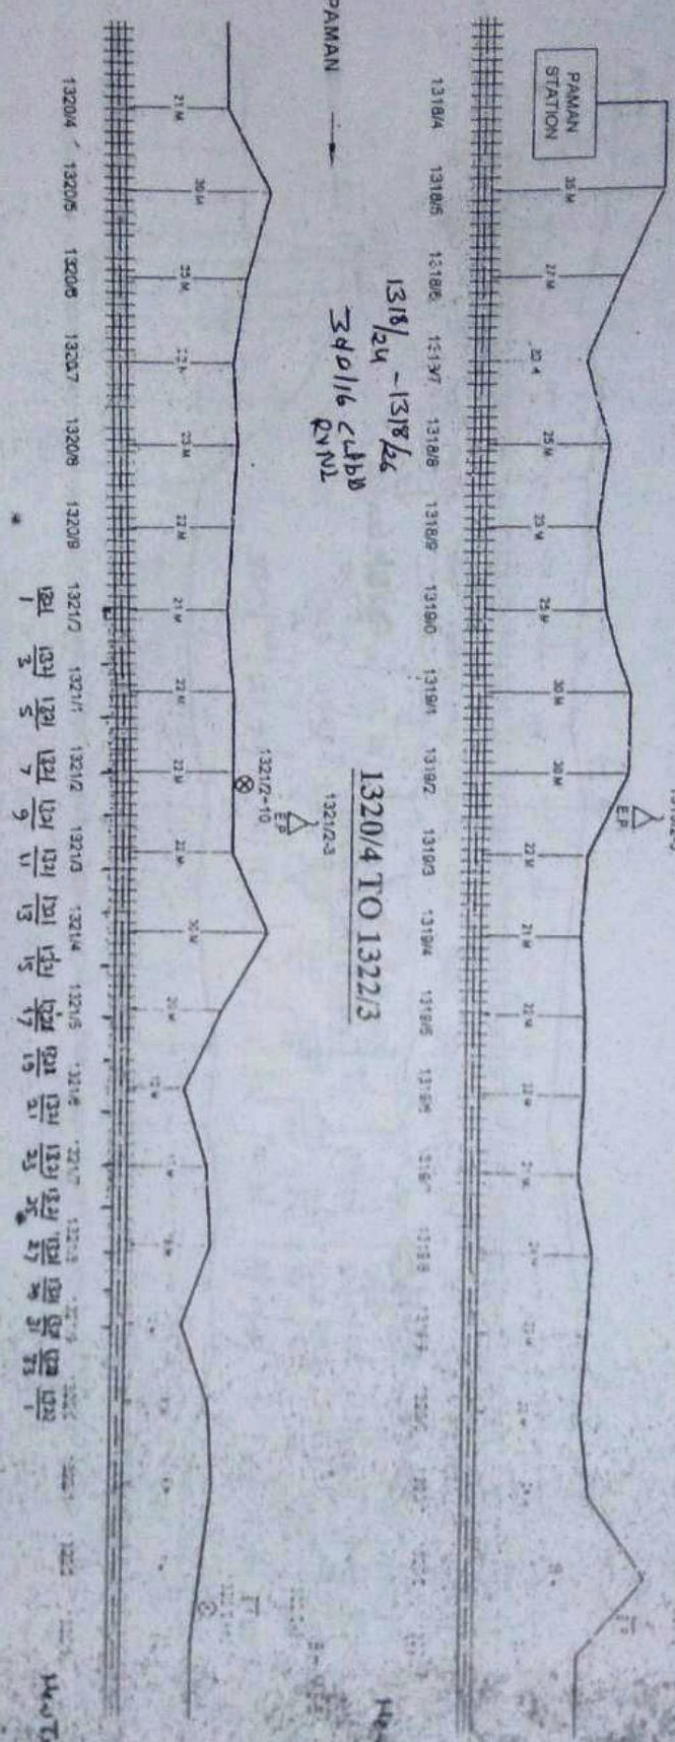

NOTE - Distance of cable is from nearest rail.

ITI LIMITED, LUCKNOW

PREPARED & CHECKED BY

Δ	EMERGENCY POST
⊗	NORMAL POSTS
≡	GATE

APPROVED BY

CABLE ROUTE PLAN


SR DISTE W/LHS	SECTION	PAMAN TO BHIMSEN
SSTE/RPMB/HHS	DRAWING NO	
SSE/TORAI	SHEET NO	

06 - QUAD CABLE - ROUTE PLAN

(PAMIAN - BHIMSEN SECTION)

1318/4 TO 1336/6

1322/4 TO 1324/3

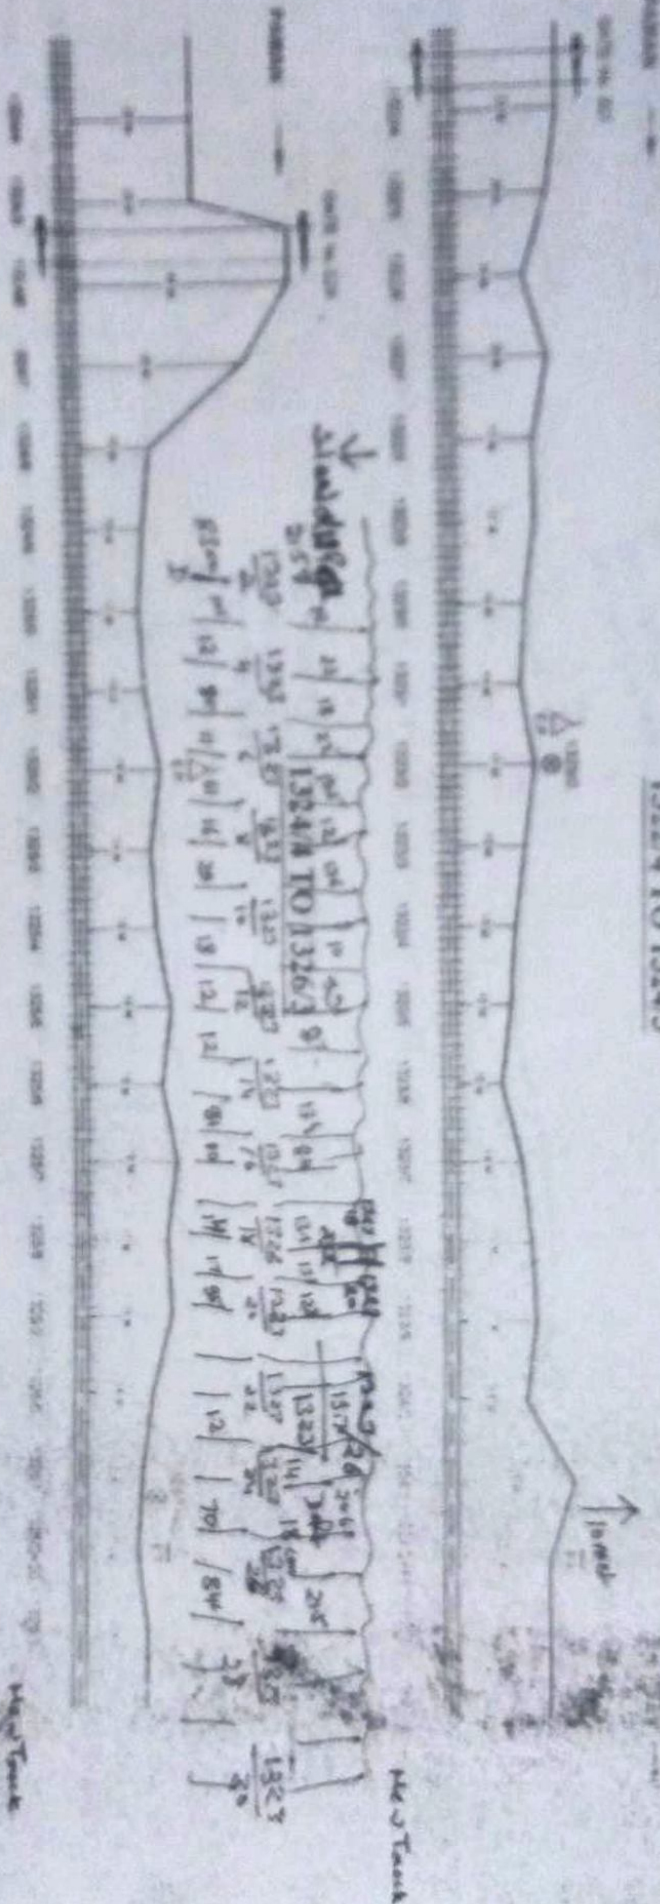

NOTE - Distance of cables is from ground (ft.)

APPROVED BY

CABLE ROUTE PLAN

SR. DIST. W-L-1113

SECTION

PAYAN'S 100 BHIMSEN

SITE/REPAIR/REH

DRAWING NO.

SECTIONAL

1-227 V.A.

MOCKEY LIMITED LUCKNOW

PREPARED & CHECKED BY

II

DATE

REVISION

NO.

DATE

REVISION

NO.

PREPARED & CHECKED BY: _____

		
R. S. J. 2007/01/21 - 2007/01/21	R. S. J. 2007/01/21 - 2007/01/21	R. S. J. 2007/01/21 - 2007/01/21

This image shows a blank, lined page from a notebook. The page is white with horizontal ruling lines and a vertical margin line on the left side. There is no text or other content on the page.

CABLE ROUTE PLAN		APPROVED BY	
SECTION	PATCH TO BE INSTALLED	SR DATE/W/LINKS	SR DATE/W/LINKS
DRAWING NO.	NO. OF SHEETS	<i>[Signature]</i>	<i>[Signature]</i>
SHEET NO.	DATE	<i>[Signature]</i>	<i>[Signature]</i>

NOTE: Distance of cable is from sensor (not

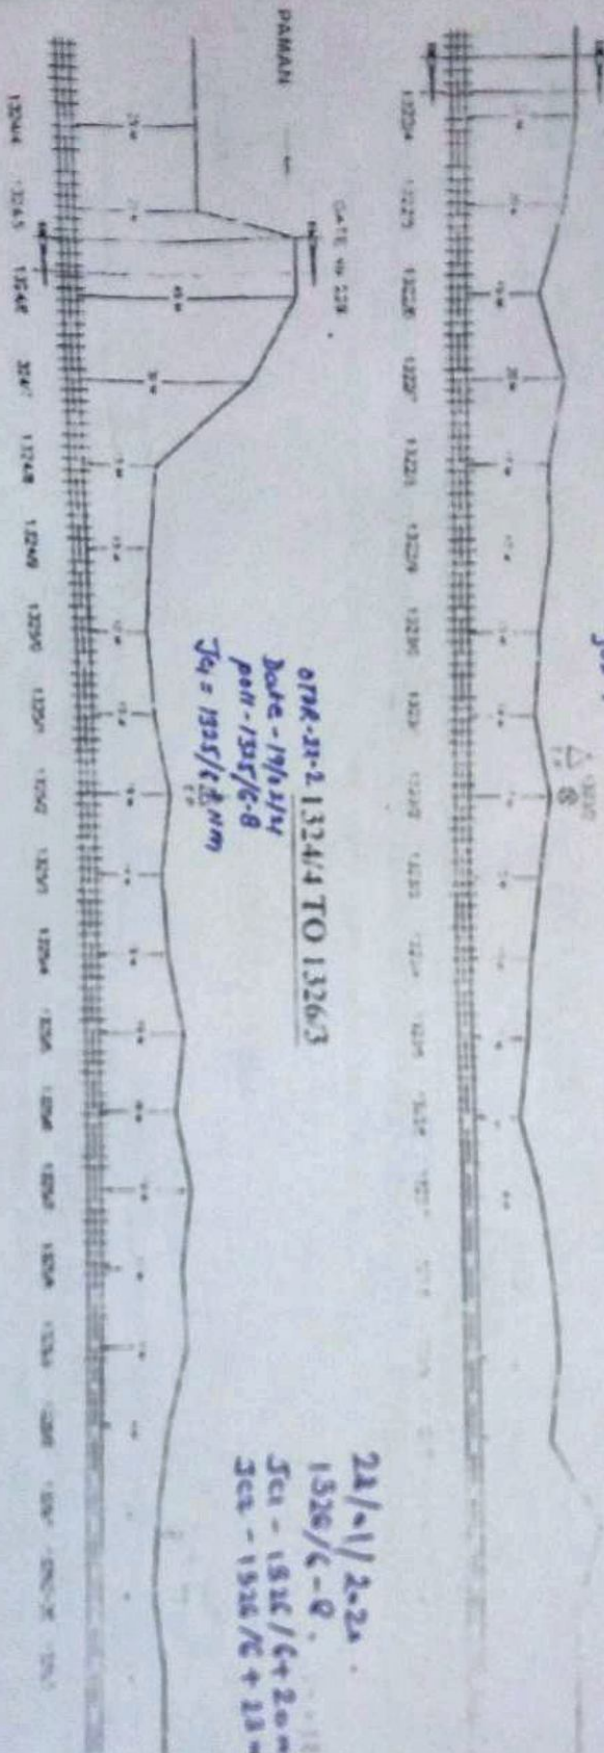

204C - 24-2 (1900/1905)
 208 - 13.23/20-22
 261 - 13.3/24.7 (1932/4 TO 1943)
 262 - 13.2/24.7

$$\begin{aligned} 2A &= 1/2 \cdot 2.25 \\ 1.526/6 &= 0 \\ Jc1 &= 1.526/6 + 2.00 \\ Jc2 &= 1.526/6 + 2.00 \end{aligned}$$

06 - QUAD CABLE - ROUTE PLAN

(PAMAN - BHIMSEN SECTION)
1318/4 TO 1333/6


→ BHIMSEN ← KANPUR →

PAMAN

GATE No. 230


1328/4

1326/4 TO 1328/3

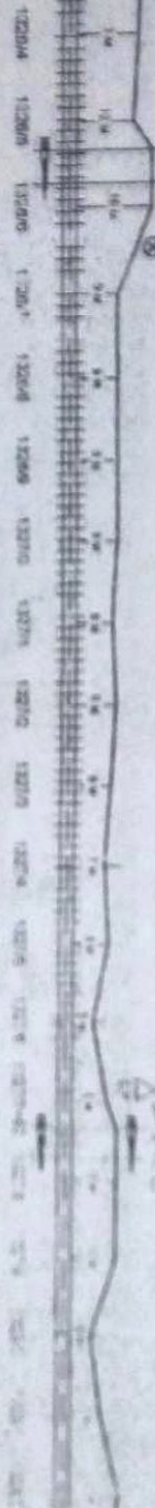

PAMAN

1328/4 TO 1330/3

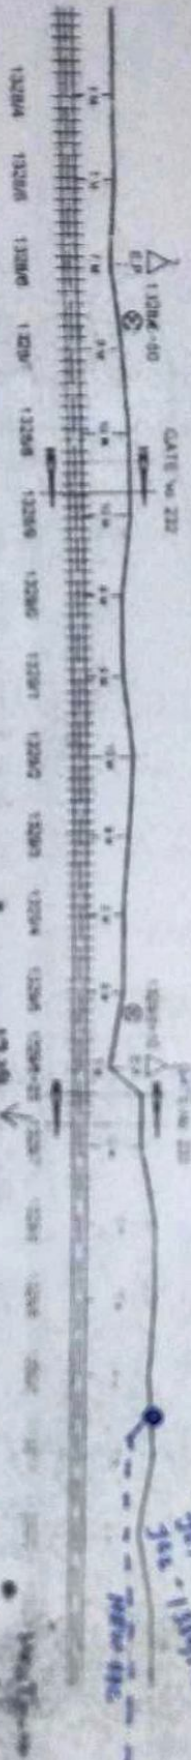

NOTE - Distance of cable is from starting rail

APPROVED BY

CABLE ROUTE PLAN

SR. DIST. W-4 JHS

[Signature]

SECTION

PAMAN TO BHIMSEN

SSTE. DR. P. M. JHS

[Signature]

DRAWING NO.

SHEET NO.

[Signature]

SHEET NO.

ITI LIMITED, LUCKNOW

PREPARED & CHECKED BY:

[Signature]

EMERGENCY PORT
NORMAL JORITY
GATE

06 - QUAD CABLE - ROUTE PLAN

(BHIMSEN TO JUHI WEST CABIN)

1333/6 TO 1343/6

← JHANSI KANPUR →

1333/7 TO 1335/6

RE Update 28/11 27/11 26/11

0.2 m
0.1 m

1333/6 1333/7 1333/8 1333/9 1334/0 1334/1 1334/2 1334/3 1334/4 1334/5 1334/6 1334/7 1334/8 1334/9 1335/0 1335/1 1335/2 1335/3 1335/4 1335/5 1335/6 1335/7 1335/8 1335/9 1336/0 1336/1 1336/2 1336/3 1336/4 1336/5 1336/6 1336/7 1336/8 1336/9 1337/0 1337/1 1337/2

1335/7 TO 1337/4

GATE No. 235

GATE No. 236

LC-236

1334/18

1334/20

NOTE :- Distance of cable is from nearest rail.

Not to Scale
All reading in mm

APPROVED BY

CABLE ROUTE PLAN

SR.DSTE/W-I/JHS

[Signature]

SECTION

BHIMSEN TO JUHI

SSTE/RPMU/JHS

[Signature]

DRAWING NO.

06 QUAD/S&T/
JHS - CNB

SSET/ORAI

[Signature]

SHEET NO.

67


PREPARED & CHECKED BY

EMERGENCY POST	ASSEMBLY POINTS
Gate	

69

1333/6 TO 1343/6

1337/5 TO 1339/3

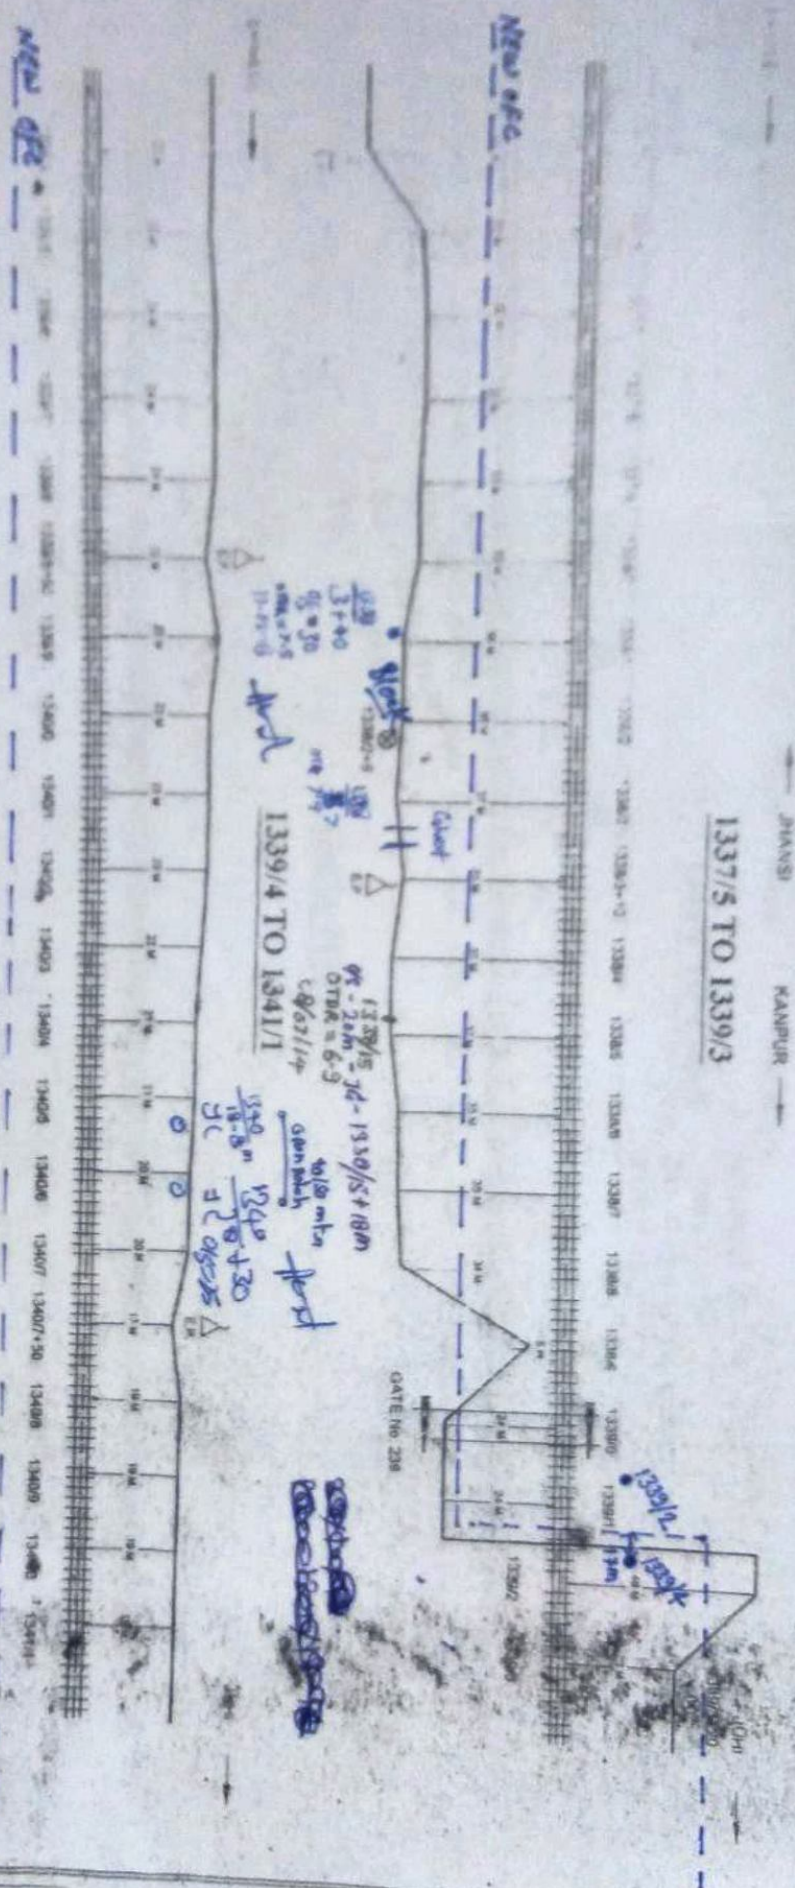

NOTE: Distance shown is from nearest rail.

Not to Scale

APPROVED BY _____		CABLE ROUTE PLAN	
SR.DSTE/W./JHS		SECTION	BHIMSEN TO JUMI
SSTE/RPM/JHS		DRAWING NO.	06.QUAD.S&T/ JHS - CNB
SSE/TORAI		SHEET NO.	68

1 BHIVISEN TO JUH WEST CABIN
1333/6 TO 1343/6

1333/6 TO 1343/6

→ JHANSI → KANPUR →

1341/2 TO 1343/0


06/12/2013

1342/17-02

501-1342/14-15 m

$$\frac{3.62 \times 10^{-12}}{1.9 \times 10^{-17} \text{ m}}$$

1374/02
1-2-2008 from C.A.S.

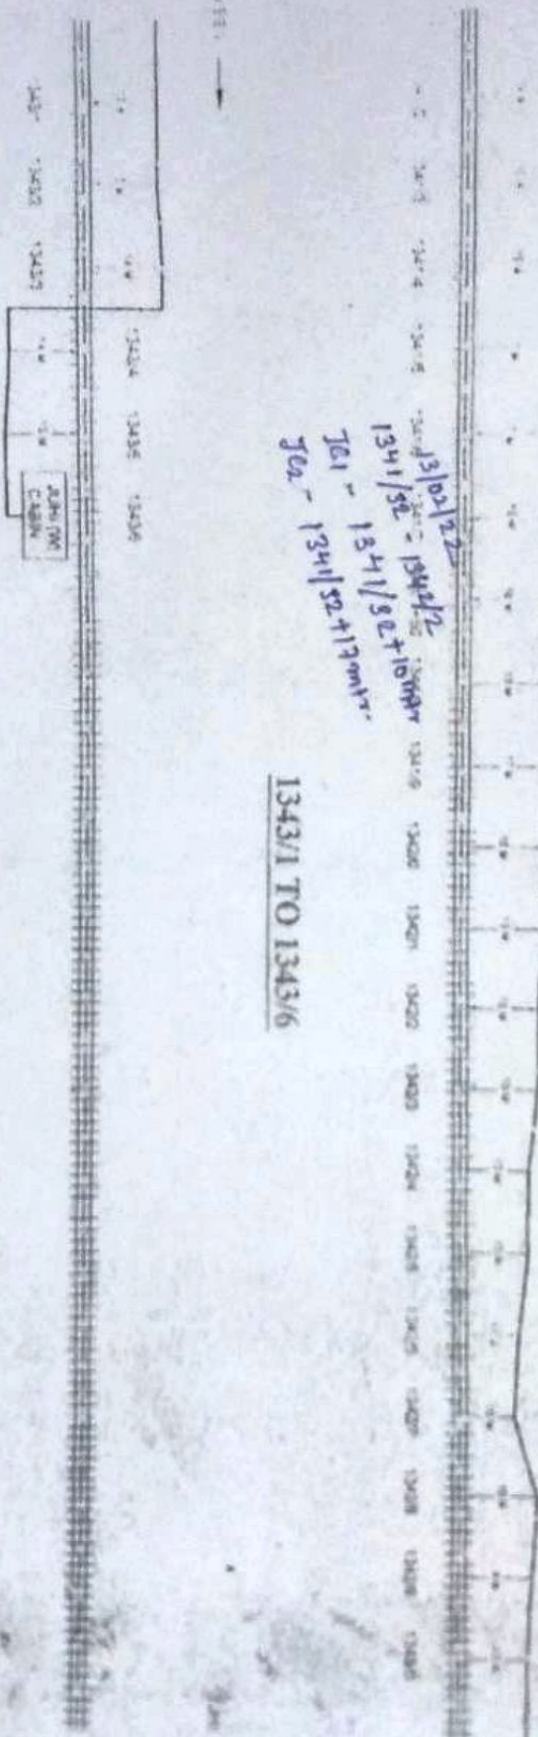

1343/1 TO 1343/6

NOTE: Distance of cable is from nearest rail

APPROVED BY

CABLE ROUTE PLAN

APPROVED BY _____		CABLE ROUTE PLAN	
SR DSTE/W-JHS		SECTION	SHIMSEN TO JAH
SSTE/IRPNU/JHS		DRAWING NO.	36 C/HEAD S&T JHS - CNB
SSELT/ORAL		SHEET NO.	69

PREPARED & CHECKED BY _____

INTRODUCTION

NORMAN JOHNSON

247